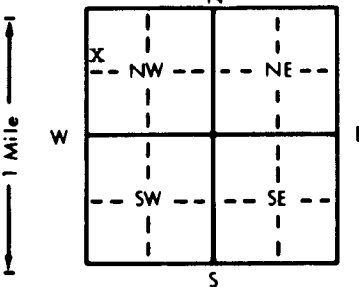


1 LOCATION OF WATER WELL: Fraction Section Number Township Number Range Number  
 County: SALINE SW 1/4 NW 1/4 NW 1/4 28 T 13 S R 2 EW

Distance and direction from nearest town or city street address of well if located within city?  
 3300 N. HOLMES RD.

2 WATER WELL OWNER: EDWARD AYLWARD  
 RR#, St. Address, Box #: 3300 N. HOLMES RD. Board of Agriculture, Division of Water Resources  
 City, State, ZIP Code: SALINA, KS. 67401 Application Number:

3 LOCATE WELL'S LOCATION WITH AN "X" IN SECTION BOX:  

 4 DEPTH OF COMPLETED WELL: 58 ft. ELEVATION: 1213  
 Depth(s) Groundwater Encountered 1. 34 ft. 2. ft. 3. ft.  
 WELL'S STATIC WATER LEVEL 34 ft. below land surface measured on mo/day/yr 12-17-91  
 Pump test data: Well water was 36 ft. after 1 hours pumping 35 gpm  
 Est. Yield 7.5+ gpm: Well water was ft. after hours pumping gpm  
 Bore Hole Diameter 9 in. to 58 ft., and in. to ft.  
 WELL WATER TO BE USED AS: 5 Public water supply 8 Air conditioning 11 Injection well  
 1 Domestic 3 Feedlot 6 Oil field water supply 9 Dewatering 12 Other (Specify below)  
 2 Irrigation 4 Industrial 7 Lawn and garden only 10 Monitoring well  
 Was a chemical/bacteriological sample submitted to Department? Yes No X; If yes, mo/day/yr sample was submitted  
 Water Well Disinfected? Yes X No

5 TYPE OF BLANK CASING USED:  
 1 Steel 3 RMP (SR) 5 Wrought iron 8 Concrete tile CASING JOINTS: Glued X Clamped  
 2 PVC 4 ABS 6 Asbestos-Cement 9 Other (specify below) Welded  
 7 Fiberglass Threaded  
 Blank casing diameter 5 in. to 48 ft., Dia in. to ft., Dia in. to ft.  
 Casing height above land surface 24 in., weight 160 lbs./ft. Wall thickness or gauge No. SDR 26  
 TYPE OF SCREEN OR PERFORATION MATERIAL:  
 1 Steel 3 Stainless steel 5 Fiberglass 7 PVC 10 Asbestos-cement  
 2 Brass 4 Galvanized steel 6 Concrete tile 8 RMP (SR) 11 Other (specify)  
 9 ABS 12 None used (open hole)  
 SCREEN OR PERFORATION OPENINGS ARE:  
 1 Continuous slot 3 Mill slot .030 5 Gauzed wrapped 8 Saw cut 11 None (open hole)  
 2 Louvered shutter 4 Key punched 7 Torch cut 9 Drilled holes 10 Other (specify)  
 SCREEN-PERFORATED INTERVALS: From 48 ft. to 58 ft., From ft. to ft.  
 From ft. to ft., From ft. to ft.  
 GRAVEL PACK INTERVALS: From 25 ft. to 58 ft., From ft. to ft.  
 From ft. to ft., From ft. to ft.

6 GROUT MATERIAL: 1 Neat cement 2 Cement grout 3 Bentonite 4 Other  
 Grout Intervals: From 5 ft. to 25 ft., From ft. to ft., From ft. to ft.  
 What is the nearest source of possible contamination:  
 1 Septic tank 4 Lateral lines 7 Pit privy 10 Livestock pens 14 Abandoned water well PLUGGED  
 2 Sewer lines 5 Cess pool 8 Sewage lagoon 11 Fuel storage 15 Oil well/Gas well  
 3 Watertight sewer lines 6 Seepage pit 9 Feedyard 12 Fertilizer storage 16 Other (specify below)  
 13 Insecticide storage  
 Direction from well? NORTH How many feet? 100

FROM	TO	LITHOLOGIC LOG	FROM	TO	PLUGGING INTERVALS
0	2	TOP SOIL			
2	25	SILT GRAY			
25	35	SILT & SAND TAN			
35	38	CLAY SOFT GRAY			
38	58	GRAVEL FINE TO COARSE			

RECEIVED

FEB 05 1992

DIVISION OF ENVIRONMENT

7 CONTRACTOR'S OR LANDOWNER'S CERTIFICATION: This water well was (1) constructed (2) reconstructed, or (3) plugged under my jurisdiction and was completed on (mo/day/year) 12-17-91 and this record is true to the best of my knowledge and belief. Kansas Water Well Contractor's License No. 388 This Water Well Record was completed on (mo/day/year) 12-17-91 under the business name of PESTINGER PUMP SERVICE by (signature) *Edward Aylward*

INSTRUCTIONS: Use typewriter or ball point pen. PLEASE PRESS FIRMLY and PRINT clearly. Please fill in blanks, underline or circle the correct answers. Send top three copies to Kansas Department of Health and Environment, Bureau of Water, Topeka, Kansas 66620-0001. Telephone: 913-296-5545. Send one to WATER WELL OWNER and retain one for your records.

OFFICE USE ONLY  
T  
R  
EW  
SEC.  
1/4  
1/4  
1/4