


1 LOCATION OF WATER WELL: County: SALINE Fraction: NW SE 1/4 NW 1/4 SW 1/4 Section Number: 18 Township Number: T 13 S Range Number: R 23 E

Distance and direction from nearest town or city street address of well if located within city?
552 S. Delaware

2 WATER WELL OWNER: LARRY Usher
 RR#, St. Address, Box #: 552 S. Delaware
 City, State, ZIP Code: Salina KS 67401
 Board of Agriculture, Division of Water Resources
 Application Number:

3 LOCATE WELL'S LOCATION WITH AN "X" IN SECTION BOX:
 4 DEPTH OF COMPLETED WELL: 51 1/2 ft. ELEVATION: 1220
 Depth(s) Groundwater Encountered 1. 32 ft. 2. _____ ft. 3. _____ ft.

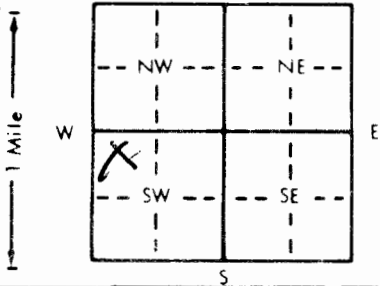

WELL'S STATIC WATER LEVEL 25 ft. below land surface measured on mo/day/yr 8-10-94
 Pump test data: Well water was 25 ft. after 1 hours pumping 15 gpm
 Est. Yield 30 gpm: Well water was _____ ft. after _____ hours pumping _____ gpm
 Bore Hole Diameter: 8 1/2 in. to 32 ft., and 5 in. to 51 1/2 ft.
 WELL WATER TO BE USED AS:
 1 Domestic 3 Feedlot 5 Public water supply 8 Air conditioning 11 Injection well
 2 Irrigation 4 Industrial 7 Lawn and garden only 9 Dewatering 12 Other (Specify below)
 Was a chemical/bacteriological sample submitted to Department? Yes _____ No X If yes, mo/day/yr sample was submitted _____
 Water Well Disinfected? Yes X No _____

5 TYPE OF BLANK CASING USED:
 1 Steel 3 RMP (SR) 5 Wrought iron 8 Concrete tile CASING JOINTS: Glued X Clamped _____
2 PVC 4 ABS 7 Fiberglass 9 Other (specify below) Welded _____
 Threaded _____

Blank casing diameter: 5 in. to 4 1/2 ft. Dia _____ in. to _____ ft. Dia _____ in. to _____ ft.
 Casing height above land surface: 18 in. weight 160 LB lbs./ft. Wall thickness or gauge No. SDR26

TYPE OF SCREEN OR PERFORATION MATERIAL:
 1 Steel 3 Stainless steel 5 Fiberglass 8 RMP (SR) 10 Asbestos-cement
 2 Brass 4 Galvanized steel 6 Concrete tile 9 ABS 11 Other (specify) _____
 12 None used (open hole)

SCREEN OR PERFORATION OPENINGS ARE:
 1 Continuous slot 3 Mill slot 5 Gauzed wrapped 8 Saw cut 11 None (open hole)
 2 Louvered shutter 4 Key punched 6 Wire wrapped 9 Drilled holes
 7 Torch cut 10 Other (specify) _____

SCREEN-PERFORATED INTERVALS: From 4 1/2 ft. to 51 1/2 ft. From _____ ft. to _____ ft.
 From _____ ft. to _____ ft. From _____ ft. to _____ ft.
 GRAVEL PACK INTERVALS: From 21 ft. to 51 1/2 ft. From _____ ft. to _____ ft.
 From _____ ft. to _____ ft. From _____ ft. to _____ ft.

6 GROUT MATERIAL: 1 Neat cement 2 Cement grout 3 Bentonite 4 Other _____
 Grout Intervals: From 0 ft. to 21 ft. From _____ ft. to _____ ft. From _____ ft. to _____ ft.

What is the nearest source of possible contamination:
 1 Septic tank 4 Lateral lines 7 Pit privy 10 Livestock pens 14 Abandoned water well
 2 Sewer lines 5 Cess pool 8 Sewage lagoon 11 Fuel storage 15 Oil well/Gas well
3 Watertight sewer lines 6 Seepage pit 9 Feedyard 12 Fertilizer storage 16 Other (specify below)
 13 Insecticide storage

Direction from well? South How many feet? 53

FROM	TO	LITHOLOGIC LOG	FROM	TO	PLUGGING INTERVALS
0'	6'	Compacted silt + dirt			
6'	15'	Fine SAND			
15'	26'	Fine SAND + clay mixed (Grey)			
26'	33'	Coarse gravel and clay mixed (Grey)			
33'	36'	clay + SAND mixed			
36'	51 1/2'	Medium to Coarse SAND + Gravel			

7 CONTRACTOR'S OR LANDOWNER'S CERTIFICATION: This water well was 1 constructed, (2) reconstructed, or (3) plugged under my jurisdiction and was completed on (mo/day/year) 8-10-94 and this record is true to the best of my knowledge and belief. Kansas Water Well Contractor's License No. 523 This Water Well Record was completed on (mo/day/yr) 8-10-94 under the business name of MWD Well Service by (signature) Matthew Soukup