


1 LOCATION OF WATER WELL: County: ELLIS Fraction NW 1/4 NW 1/4 SW 1/4 Section Number 9 Township Number T 13 S Range Number R 20 E/W

Distance and direction from nearest town or city street address of well if located within city? 305 E 13th St ~~MAXXKKSX~~ ELLIS KS

2 WATER WELL OWNER: SALLY WARD RR#, St. Address, Box #: 305 E 13th City, State, ZIP Code: ELLIS KS 67637 Board of Agriculture, Division of Water Resources Application Number:

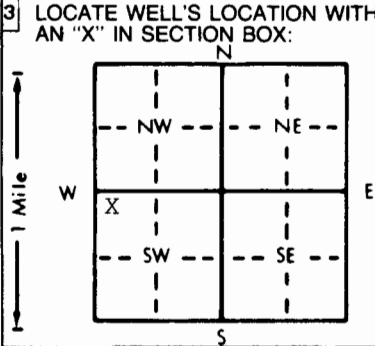

4 DEPTH OF COMPLETED WELL: 68 ft. ELEVATION: Depth(s) Groundwater Encountered 1. 38 ft. 2. ft. 3. ft. WELL'S STATIC WATER LEVEL: 38 ft. below land surface measured on mo/day/yr 5-2-97 Pump test data: Well water was ft. after hours pumping gpm Est. Yield 30 gpm Well water was ft. after hours pumping gpm Bore Hole Diameter 10 in. to 68 ft., and in. to ft. WELL WATER TO BE USED AS: 5 Public water supply 8 Air conditioning 11 Injection well 1 Domestic 3 Feedlot 6 Oil field water supply 9 Dewatering 12 Other (Specify below) 2 Irrigation 4 Industrial ~~XX~~ Lawn and garden only 10 Monitoring well Was a chemical/bacteriological sample submitted to Department? Yes No ~~XX~~; If yes, mo/day/yr sample was submitted Water Well Disinfected? Yes No ~~XX~~

5 TYPE OF BLANK CASING USED: 1 Steel 3 RMP (SR) 5 Wrought iron 8 Concrete tile CASING JOINTS: Glued ~~XX~~ Clamped Welded Threaded 2 PVC 4 ABS 6 Asbestos-Cement 9 Other (specify below) 7 Fiberglass Blank casing diameter 5 in. to 48 ft., Dia 18 in. to 160 lbs./ft. Wall thickness or gauge No. Casing height above land surface 18 in., weight 160 lbs./ft. TYPE OF SCREEN OR PERFORATION MATERIAL: 1 Steel 3 Stainless steel 5 Fiberglass 8 RMP (SR) 10 Asbestos-cement 2 Brass 4 Galvanized steel 6 Concrete tile 9 ABS 11 Other (specify) 12 None used (open hole) SCREEN OR PERFORATION OPENINGS ARE: 1 Continuous slot 2 Mill slot 3 Mill slot 4 Key punched 5 Gauzed wrapped 6 Wire wrapped 7 Torch cut 8 Saw cut 9 Drilled holes 11 None (open hole) SCREEN-PERFORATED INTERVALS: From 48 ft. to 68 ft., From ft. to ft. GRAVEL PACK INTERVALS: From 25 ft. to 68 ft., From ft. to ft.

6 GROUT MATERIAL: 1 Neat cement 2 Cement grout 3 Bentonite 4 Other Grout Intervals: From 0 ft. to 25 ft., From ft. to ft. What is the nearest source of possible contamination: 1 Septic tank 4 Lateral lines 7 Pit privy 10 Livestock pens 14 Abandoned water well 2 Sewer lines 5 Cess pool 8 Sewage lagoon 11 Fuel storage 15 Oil well/Gas well 3 Watertight sewer lines 6 Seepage pit 9 Feedyard 12 Fertilizer storage 16 Other (specify below) 13 Insecticide storage Direction from well? How many feet?

FROM	TO	LITHOLOGIC LOG	FROM	TO	PLUGGING INTERVALS
0	10	SURFACE CLAY			
10	25	YELLOW CLAY			
25	35	FINE SAND			
35	45	BLUE S MUD			
45	55	MED SAND			
55	65	LARGE SAND			
65	68	BLUE SHALE			

7 CONTRACTOR'S OR LANDOWNER'S CERTIFICATION: This water well was (1) constructed, (2) reconstructed, or (3) plugged under my jurisdiction and was completed on (mo/day/year) 5-2-97 and this record is true to the best of my knowledge and belief. Kansas Water Well Contractor's License No. 444 This Water Well Record was completed on (mo/day/yr) 5-2-97 under the business name of ANDERSON DRILLING by (signature) *Cindy Anderson*

INSTRUCTIONS: Use typewriter or ball point pen. PLEASE PRESS FIRMLY and PRINT clearly. Please fill in blanks, underline or circle the correct answers. Send top three copies to Kansas Department of Health and Environment, Bureau of Water, Topeka, Kansas 66620-0001. Telephone: 913-296-5545. Send one to WATER WELL OWNER and retain one for your records.

OFFICE USE ONLY
T
R
EW
SEC.
1/4
1/4
1/4