


1 LOCATION OF WATER WELL: County: ELLIS Fraction: SE 1/4 SE 1/4 SE 1/4 Section Number: 5 Township Number: T 13 S Range Number: R 20 E/W

Distance and direction from nearest town or city street address of well if located within city?
308 Dorrance ELLIS Ks.

2 WATER WELL OWNER: Kenny Windholz
 RR#, St. Address, Box #: 308 Dorrance
 City, State, ZIP Code: ELLIS Ks. 67637
 Board of Agriculture, Division of Water Resources
 Application Number:

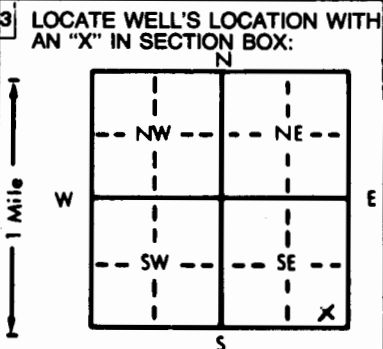

4 DEPTH OF COMPLETED WELL: 39 ft. ELEVATION: ft.
 Depth(s) Groundwater Encountered 1. 25 ft. 2. ft. 3. ft.
 WELL'S STATIC WATER LEVEL: 10 ft. below land surface measured on mo/day/yr 9/22/86
 Pump test data: Well water was 10 ft. after 1 hours pumping 20 gpm
 Est. Yield 20 gpm: Well water was ft. after hours pumping gpm
 Bore Hole Diameter: 10 in. to ft., and in. to ft.
 WELL WATER TO BE USED AS:
 1 Domestic 3 Feedlot 6 Oil field water supply 9 Dewatering 12 Other (Specify below)
 2 Irrigation 4 Industrial 7 Lawn and garden only 10 Observation well
 Was a chemical/bacteriological sample submitted to Department? Yes.....No..... If yes, mo/day/yr sample was submitted
 Water Well Disinfected? Yes No

5 TYPE OF BLANK CASING USED:
 1 Steel 3 RMP (SR) 5 Wrought iron 8 Concrete tile CASING JOINTS: Glued Clamped
 2 PVC 4 ABS 6 Asbestos-Cement 9 Other (specify below) Welded
 7 Fiberglass Threaded.....
 Blank casing diameter: 5 in. to ft., Dia. in. to ft., Dia. in. to ft.
 Casing height above land surface: 1.8 in., weight lbs./ft. Wall thickness or gauge No. SDR 26
 TYPE OF SCREEN OR PERFORATION MATERIAL:
 1 Steel 3 Stainless steel 5 Fiberglass 8 RMP (SR) 11 Other (specify)
 2 Brass 4 Galvanized steel 6 Concrete tile 9 ABS 12 None used (open hole)
 SCREEN OR PERFORATION OPENINGS ARE:
 1 Continuous slot 3 Mill slot 5 Gauzed wrapped 8 Saw cut 11 None (open hole)
 2 Louvered shutter 4 Key punched 6 Wire wrapped 9 Drilled holes
 7 Torch cut 10 Other (specify)
 SCREEN-PERFORATED INTERVALS: From 1.9 ft. to 2.9 ft., From ft. to ft.
 From ft. to ft., From ft. to ft.
 GRAVEL PACK INTERVALS: From 1.9 ft. to 3.9 ft., From ft. to ft.
 From ft. to ft., From ft. to ft.

6 GROUT MATERIAL: 1 Neat cement 2 Cement grout 3 Bentonite 4 Other
 Grout Intervals: From 5 ft. to 15 ft., From ft. to ft., From ft. to ft.
 What is the nearest source of possible contamination:
 1 Septic tank 4 Lateral lines 7 Pit privy 10 Livestock pens 14 Abandoned water well
 2 Sewer lines 5 Cess pool 8 Sewage lagoon 11 Fuel storage 15 Oil well/Gas well
 3 Watertight sewer lines 6 Seepage pit 9 Feedyard 12 Fertilizer storage 16 Other (specify below)
 13 Insecticide storage
 Direction from well? East
 How many feet? 200

FROM	TO	LITHOLOGIC LOG	FROM	TO	LITHOLOGIC LOG
0	10	top soil			
10	25	brown clay mixed with fine grey sand			
25	36	med to fine red & grey sand			
36	39	shale			

7 CONTRACTOR'S OR LANDOWNER'S CERTIFICATION: This water well was (1) constructed, (2) reconstructed, or (3) plugged under my jurisdiction and was completed on (mo/day/year) 9/22/86 and this record is true to the best of my knowledge and belief. Kansas Water Well Contractor's License No. 276 This Water Well Record was completed on (mo/day/yr) 9/22/86 under the business name of Luca Water Well Drilling by (signature) John Luca

INSTRUCTIONS: Use typewriter or ball point pen. PLEASE PRESS FIRMLY and PRINT clearly. Please fill in blanks, underline or circle the correct answers. Send top three copies to Kansas Department of Health and Environment, Office of Oil Field and Environmental Geology, Regulation and Permitting Section, Topeka, Kansas 66620-7500, Telephone: 913-862-9360. Send one to WATER WELL OWNER and retain one for your records.