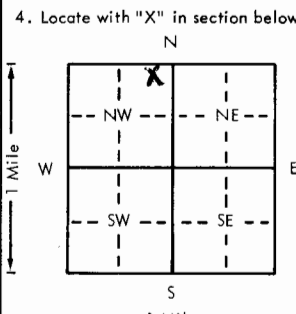


USE TYPEWRITER OR BALL POINT PEN-PRESS FIRMLY, PRINT CLEARLY.

WATER WELL RECORD
KSA 82a-1201-1215

Kansas Department of Health and Environment-Division of Environment
(Water well Contractors)
Topeka, Kansas 66620

1. Location of well: County <u>Ellis, Ks.</u> Fraction <u>NE 1/4 NE 1/4 NW 1/4</u> Section number <u>8</u> Township number <u>T 13 S R 20</u> Range number <u>20</u> E/W	
2. Distance and direction from nearest town or city: Street address of well location if in city: <u>211 W 12th St Ellis, Ks.</u>	
3. Owner of well: <u>Herhardt Schoenthaler</u> R.R. or street: <u>211 W 12th</u> City, state, zip code: <u>Ellis, Ks 67637</u>	
4. Locate with "X" in section below: Sketch map: 	
5. Type and color of material	
6. Bore hole dia. <u>10</u> in. Completion date <u>8-14-78</u> Well depth <u>37</u> ft.	
7. <input checked="" type="checkbox"/> Cable tool <input checked="" type="checkbox"/> Rotary <input type="checkbox"/> Driven <input type="checkbox"/> Dug <input type="checkbox"/> Hollow rod <input type="checkbox"/> Jetted <input type="checkbox"/> Bored <input type="checkbox"/> Reverse rotary	
8. Use: <input type="checkbox"/> Domestic <input type="checkbox"/> Public supply <input type="checkbox"/> Industry <input type="checkbox"/> Irrigation <input type="checkbox"/> Air conditioning <input type="checkbox"/> Stock <input checked="" type="checkbox"/> Lawn <input type="checkbox"/> Oil field water <input type="checkbox"/> Other	
9. Casing: Material <u>Pite</u> Height <u>Above</u> or below Threaded <input type="checkbox"/> Welded <u>glu</u> Surface <u>18</u> in. RMP <input type="checkbox"/> PVC <u>glu</u> Weight <input type="checkbox"/> lbs./ft. Dia. <u>5</u> in. to <u>21</u> ft. depth Wall Thickness: inches or Dia. <input type="checkbox"/> in. to <input type="checkbox"/> ft. depth gage No. <u>1/4"</u>	
10. Screen: Manufacturer's name <u>Jess + Howell</u> Type <u>Pite</u> Dia. <u>5</u> Slot gauze <input checked="" type="checkbox"/> Length <u>16</u> Set between <u>21</u> ft. and <u>37</u> ft. <input type="checkbox"/> ft. and <input type="checkbox"/> ft. Gravel pack? <input checked="" type="checkbox"/> Size range of material <u>1/8-1/4"</u>	
11. Static water level: <u>19</u> ft. below land surface Date <u>8-14-78</u> mo./day/yr.	
12. Pumping level below land surfaces: <u>19</u> ft. after <u>1</u> hrs. pumping <u>12</u> g.p.m. <input type="checkbox"/> ft. after <input type="checkbox"/> hrs. pumping <input type="checkbox"/> g.p.m. Estimated maximum yield <u>12</u> g.p.m.	
13. Water sample submitted: <input type="checkbox"/> Yes <input checked="" type="checkbox"/> No Date <input type="checkbox"/> mo./day/yr.	
14. Well head completion: <input checked="" type="checkbox"/> Pitless adapter <u>18</u> inches above grade	
15. Well grouted? <input type="checkbox"/> With: <input checked="" type="checkbox"/> Neat cement <input type="checkbox"/> Bentonite <input type="checkbox"/> Concrete Depth: From <u>0</u> ft. to <u>10</u> ft.	
16. Nearest source of possible contamination: <u>20</u> ft. Direction <u>East</u> Type <u>Serentine</u> Well disinfected upon completion? <input type="checkbox"/> Yes <input type="checkbox"/> No	
17. Pump: <input type="checkbox"/> Not installed Manufacturer's name <input type="checkbox"/> Model number <input type="checkbox"/> HP <input type="checkbox"/> Volts <input type="checkbox"/> Length of drop pipe <input type="checkbox"/> ft. capacity <input type="checkbox"/> g.p.m. Type: <input type="checkbox"/> Submersible <input type="checkbox"/> Turbine <input type="checkbox"/> Jet <input type="checkbox"/> Reciprocating <input type="checkbox"/> Centrifugal <input type="checkbox"/> Other	
(Use a second sheet if needed)	
18. Elevation: Topography: <input type="checkbox"/> Hill <input type="checkbox"/> Slope <input checked="" type="checkbox"/> Upland <input type="checkbox"/> Valley	19. Remarks: <u>I do not install pumps</u>
20. Water well contractor's certification: This well was drilled under my jurisdiction and this report is true to the best of my knowledge and belief. <u>Luce Water Well Bldg 276</u> Business name <u>503 Monroe St Ellis, Ks</u> License No. <input type="checkbox"/> Address <u>Jake Luce</u> Date <u>8-14-78</u> Signed <u>Jake Luce</u> Authorized representative	

T 13 R 20 S 8 NE 1/4 NE 1/4