


1 LOCATION OF WATER WELL: Fraction NE 1/4 NE 1/4 SE 1/4 Section Number 8 Township Number T 13 S Range Number R 20 E
 County: Ellis

Distance and direction from nearest town or city street address of well if located within city?
605 W 12th Ellis Ks. 67637

2 WATER WELL OWNER: IRVIN Kuhn
 RR#, St. Address, Box #: 605 W 12th Board of Agriculture, Division of Water Resources
 City, State, ZIP Code: Ellis Ks 67637 Application Number:

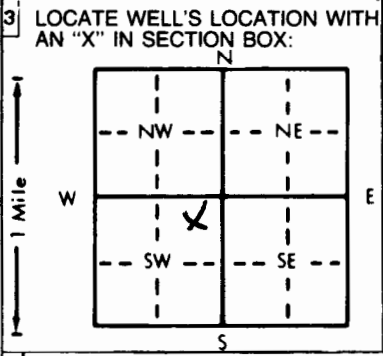

4 DEPTH OF COMPLETED WELL: 55 ft. ELEVATION:
 Depth(s) Groundwater Encountered 1. 32 ft. 2. ft. 3. ft.
 WELL'S STATIC WATER LEVEL: 30 ft. below land surface measured on mo/day/yr 5-9-91
 Pump test data: Well water was 12 ft. after 1 1/2 hours pumping 20 gpm
 Est. Yield 20 gpm; Well water was ft. after hours pumping gpm
 Bore Hole Diameter: 1.0 in. to ft., and in. to ft.
 WELL WATER TO BE USED AS:
 1 Domestic 3 Feedlot 6 Oil field water supply 9 Dewatering 12 Other (Specify below)
 2 Irrigation 4 Industrial 7 Lawn and garden only 10 Monitoring well
 Was a chemical/bacteriological sample submitted to Department? Yes No If yes, mo/day/yr sample was submitted
 Water Well Disinfected? Yes No

5 TYPE OF BLANK CASING USED:
 1 Steel 3 RMP (SR) 5 Wrought iron 8 Concrete tile CASING JOINTS: Glued Clamped
 2 PVC 4 ABS 6 Asbestos-Cement 9 Other (specify below) Welded
 7 Fiberglass Threaded
 Blank casing diameter 2.5 in. to ft., Dia. in. to ft., Dia. in. to ft., Dia. in. to ft.
 Casing height above land surface: 20 in., weight lbs./ft. Wall thickness or gauge No. SDR-21
 TYPE OF SCREEN OR PERFORATION MATERIAL:
 1 Steel 3 Stainless steel 5 Fiberglass 8 PVC 10 Asbestos-cement
 2 Brass 4 Galvanized steel 6 Concrete tile 9 ABS 11 Other (specify)
 12 None used (open hole)
 SCREEN OR PERFORATION OPENINGS ARE:
 1 Continuous slot 3 Mill slot 5 Gauzed wrapped 8 Saw cut 11 None (open hole)
 2 Louvered shutter 4 Key punched 6 Wire wrapped 9 Drilled holes
 7 Torch cut 10 Other (specify)
 SCREEN-PERFORATED INTERVALS: From 35 ft. to 55 ft., From ft. to ft., From ft. to ft., From ft. to ft.
 GRAVEL PACK INTERVALS: From 25 ft. to 55 ft., From ft. to ft., From ft. to ft., From ft. to ft.

6 GROUT MATERIAL: 1 Neat cement 2 Cement grout 3 Bentonite 4 Other
 Grout Intervals: From 2 ft. to 23 ft., From ft. to ft., From ft. to ft., From ft. to ft.
 What is the nearest source of possible contamination:
 1 Septic tank 4 Lateral lines 7 Pit privy 10 Livestock pens 14 Abandoned water well
 2 Sewer lines 5 Cess pool 8 Sewage lagoon 11 Fuel storage 15 Oil well/Gas well
 3 Watertight sewer lines 6 Seepage pit 9 Feedyard 12 Fertilizer storage 16 Other (specify below)
 13 Insecticide storage
 Direction from well? East How many feet? 40-50

FROM	TO	LITHOLOGIC LOG	FROM	TO	PLUGGING INTERVALS
0	10	Top soil			
10	30	BROWN clay			
30	48	Fine to med grey sand			
48	55	shale			

7 CONTRACTOR'S OR LANDOWNER'S CERTIFICATION: This water well was constructed (2) reconstructed, or (3) plugged under my jurisdiction and was completed on (mo/day/year) 5-9-91 and this record is true to the best of my knowledge and belief. Kansas Water Well Contractor's License No. 226 This Water Well Record was completed on (mo/day/yr) 5-9-91 under the business name of huer Water Well Drilling by (signature) Jalen Huer