


1 LOCATION OF WATER WELL: County: Ellis	Fraction NE 1/4 SW 1/4 NE 1/4	Section Number 9	Township Number T 13 S	Range Number R 20 EW
--	----------------------------------	---------------------	---------------------------	-------------------------

Distance and direction from nearest town or city street address of well if located within city?
 Located at Ellis City Landfill For Exact Location Contact Bucher, Willis & Ratliff - Salina, KS

2 WATER WELL OWNER: Ellis, city of
 RR#, St. Address, Box # :
 City, State, ZIP Code : Ellis, KS 67637
 Board of Agriculture, Division of Water Resources
 Application Number: not available

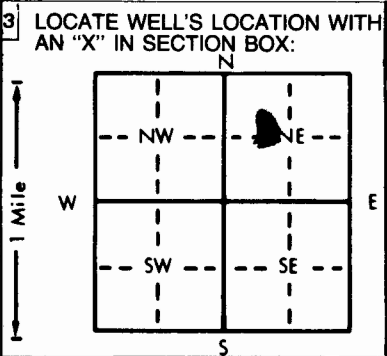

4 DEPTH OF COMPLETED WELL: 36 1/2 ft. ELEVATION: unknown
 Depth(s) Groundwater Encountered 1. 19 ft. 2. ft. 3. ft.
 WELL'S STATIC WATER LEVEL: 19 ft. below land surface measured on mo/day/yr 7/17/85
 Pump test data: Well water was not ck'd ft. after hours pumping gpm
 Est. Yield unknown gpm: Well water was ft. after hours pumping gpm
 Bore Hole Diameter: 11 in. to 15 ft., and 8 3/4 in. to 45 ft.
 WELL WATER TO BE USED AS:
 5 Public water supply 8 Air conditioning 11 Injection well
 1 Domestic 3 Feedlot 6 Oil field water supply 9 Dewatering 12 Other (Specify below)
 2 Irrigation 4 Industrial 7 Lawn and garden only 10 Observation well MONITOR
 Was a chemical/bacteriological sample submitted to Department? Yes No X; If yes, mo/day/yr sample was submitted
 Water Well Disinfected? Yes No X

5 TYPE OF BLANK CASING USED:
 1 Steel 3 RMP (SR) 5 Wrought iron 8 Concrete tile CASING JOINTS: Glued X Clamped
 2 PVC 4 ABS 6 Asbestos-Cement 9 Other (specify below) Welded
 7 Fiberglass Threaded
 Blank casing diameter 4.5 OD in. to 20.5 ft., Dia in. to ft., Dia in. to ft.
 Casing height above land surface 30 in., weight 2.001 lbs./ft. Wall thickness or gauge No. 237
 TYPE OF SCREEN OR PERFORATION MATERIAL:
 1 Steel 3 Stainless steel 5 Fiberglass 7 PVC 10 Asbestos-cement
 2 Brass 4 Galvanized steel 6 Concrete tile 8 RMP (SR) 11 Other (specify)
 9 ABS 12 None used (open hole)
 SCREEN OR PERFORATION OPENINGS ARE:
 1 Continuous slot 3 Mill slot 5 Gauzed wrapped 8 Saw cut 11 None (open hole)
 2 Louvered shutter 4 Key punched 6 Wire wrapped 9 Drilled holes
 7 Torch cut 10 Other (specify)
 SCREEN-PERFORATED INTERVALS: From 20.5 ft. to 36.5 ft., From ft. to ft.
 From ft. to ft., From ft. to ft.
 GRAVEL PACK INTERVALS: From 12 ft. to 34 ft., From ft. to ft.
 From ft. to ft., From ft. to ft.

6 GROUT MATERIAL: (A) 1 Neat cement 2 Cement grout (B) 3 Bentonite 4 Other
 Grout Intervals: From (A) 0 ft. to 10 ft., From (B) 10 ft. to 12 ft., From ft. to ft.
 What is the nearest source of possible contamination:
 1 Septic tank 4 Lateral lines 7 Pit privy 10 Livestock pens 14 Abandoned water well
 2 Sewer lines 5 Cess pool 8 Sewage lagoon 11 Fuel storage 15 Oil well/Gas well
 3 Watertight sewer lines 6 Seepage pit 9 Feedyard 12 Fertilizer storage 16 Other (specify below)
 13 Insecticide storage LANDFILL
 Direction from well? below How many feet? right on top of

FROM	TO	LITHOLOGIC LOG	FROM	TO	LITHOLOGIC LOG
0	21	Landfill, fill dirt, silt, glass old car bodies, tin			
21	23	Sandy tan clay			
23	33	Gravel, medium to coarse			
30	34	Shaley clay			
34	45	Shale			

7 CONTRACTOR'S OR LANDOWNER'S CERTIFICATION: This water well was (1) constructed, (2) reconstructed, or (3) plugged under my jurisdiction and was completed on (mo/day/year) 7/17/85 and this record is true to the best of my knowledge and belief. Kansas Water Well Contractor's License No. 185. This Water Well Record was completed on (mo/day/yr) 7/25/85 under the business name of Clarke Well & Eq., Inc. by (signature)

INSTRUCTIONS: Use typewriter or ball point pen, PLEASE PRESS FIRMLY and PRINT clearly. Please fill in blanks, underline or circle the correct answers. Send top three copies to Kansas Department of Health and Environment, Division of Environment, Environmental Geology Section, Topeka, KS 66620. Send one to WATER WELL OWNER and retain one for your records.