


1 LOCATION OF WATER WELL: County: Ellis, Ks Fraction: SE 1/4 SW 1/4 SW 1/4 Section Number: 22 Township Number: T 13 S Range Number: R 20 EW

Distance and direction from nearest town or city street address of well if located within city?  
1 1/2 South + 1 1/2 miles East of Ellis, Ks.

2 WATER WELL OWNER: Kenneth Helman  
 RR#, St. Address, Box #: R.F.D. Board of Agriculture, Division of Water Resources  
 City, State, ZIP Code: Ellis, Kansas 67637 Application Number:

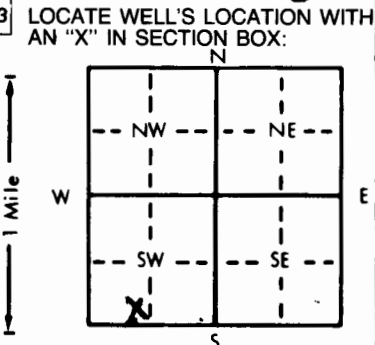

4 DEPTH OF COMPLETED WELL: 46 ft. ELEVATION:  
 Depth(s) Groundwater Encountered 1. 27 ft. 2. ft. 3. ft.  
 WELL'S STATIC WATER LEVEL: 19 ft. below land surface measured on mo/day/yr 10-1-82  
 Pump test data: Well water was ft. after hours pumping gpm  
 Est. Yield 20 gpm: Well water was 19 ft. after 1 hours pumping 20 gpm  
 Bore Hole Diameter: 10 in. to ft., and in. to ft.  
 WELL WATER TO BE USED AS:  
 1 Domestic     3 Feedlot     6 Oil field water supply     9 Dewatering     12 Other (Specify below)  
 2 Irrigation     4 Industrial     7 Lawn and garden only     10 Observation well  
 Was a chemical/bacteriological sample submitted to Department? Yes  No  If yes, mo/day/yr sample was submitted  
 Water Well Disinfected? Yes  No

5 TYPE OF BLANK CASING USED:  
 1 Steel     3 RMP (SR)     5 Wrought iron     8 Concrete tile    CASING JOINTS  Glued     Clamped  
 2 PVC     4 ABS     6 Asbestos-Cement     9 Other (specify below)     Welded  
 Blank casing diameter 5 in. to 26 ft., Dia. in. to ft., Dia. in. to ft.  
 Casing height above land surface 24 in., weight lbs./ft. Wall thickness or gauge No. 1/4 inch  
 TYPE OF SCREEN OR PERFORATION MATERIAL:  
 1 Steel     3 Stainless steel     5 Fiberglass     8 RMP (SR)     10 Asbestos-cement  
 2 Brass     4 Galvanized steel     6 Concrete tile     9 ABS     11 Other (specify)  
 12 None used (open hole)  
 SCREEN OR PERFORATION OPENINGS ARE:  
 1 Continuous slot     3 Mill slot     5 Gauzed wrapped     8 Saw cut     11 None (open hole)  
 2 Louvered shutter     4 Key punched     6 Wire wrapped     9 Drilled holes  
 7 Torch cut     10 Other (specify)  
 SCREEN-PERFORATED INTERVALS: From 26 ft. to 46 ft., From ft. to ft., From ft. to ft.  
 GRAVEL PACK INTERVALS: From 18 ft. to 46 ft., From ft. to ft., From ft. to ft.

6 GROUT MATERIAL:  1 Neat cement     2 Cement grout     3 Bentonite     4 Other  
 Grout Intervals: From 6 ft. to 17 ft., From ft. to ft., From ft. to ft.  
 What is the nearest source of possible contamination:  
 1 Septic tank     4 Lateral lines     7 Pit privy     10 Livestock pens     14 Abandoned water well  
 2 Sewer lines     5 Cess pool     8 Sewage lagoon     11 Fuel storage     15 Oil well/Gas well  
 3 Watertight sewer lines     6 Seepage pit     9 Feedyard     12 Fertilizer storage     16 Other (specify below)  
 13 Insecticide storage  
 Direction from well? SE How many feet? 8

FROM	TO	LITHOLOGIC LOG	FROM	TO	LITHOLOGIC LOG
0	4	Topsoil			
4	6	Sand F.S.			
6	45	Yellow Limestone			
45	46	Blue shale			

7 CONTRACTOR'S OR LANDOWNER'S CERTIFICATION: This water well was  (1) constructed, (2) reconstructed, or (3) plugged under my jurisdiction and was completed on (mo/day/year) 10-1-82 and this record is true to the best of my knowledge and belief. Kansas Water Well Contractor's License No. 276 This Water Well Record was completed on (mo/day/yr) 10-1-82 under the business name of Luna Water Well Drilling by (signature) John Luna

INSTRUCTIONS: Use typewriter or ball point pen, PLEASE PRESS FIRMLY and PRINT clearly. Please fill in blanks, underline or circle the correct answers. Send top three copies to Kansas Department of Health and Environment, Division of Environment, Environmental Geology Section, Topeka, KS 66620. Send one to WATER WELL OWNER and retain one for your records.

OFFICE USE ONLY  
T  
13  
R  
20  
EW  
SEC: 22  
SE 1/4 SW 1/4 SW 1/4