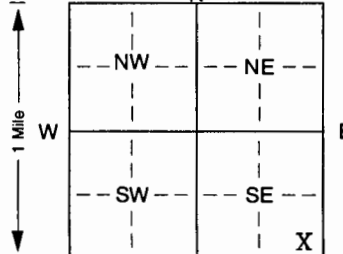


1 LOCATION OF WATER WELL: Fraction SE 1/4 SE 1/4 SE 1/4 Section Number 5 Township Number T 13 S R 20 Range Number 17W  
 County: Ellis

Distance and direction from nearest town or city street address of well if located within city?  
305 W 3rd; Ellis KS

2 WATER WELL OWNER: Brad Frickey  
 RR#, St. Address, Box #: 305 W 3rd Board of Agriculture, Division of Water Resources  
 City, State, ZIP Code: Ellis KS 67637 Application Number:

3 LOCATE WELL'S LOCATION WITH AN "X" IN SECTION BOX:  
  
 4 DEPTH OF COMPLETED WELL: 65 ft. ELEVATION: valley  
 Depth(s) Groundwater Encountered 1. 26 ft. 2. 32 ft. 3. 32 ft.  
 WELL'S STATIC WATER LEVEL: 32 ft. below land surface measured on mo/day/yr 7/26/01  
 Pump test data: Well water was 32 ft. after 2 hours pumping 15 gpm  
 Est. Yield 15 gpm: Well water was 32 ft. after 2 hours pumping 15 gpm  
 Bore Hole Diameter: 10 in. to 65 ft., and 10 in. to 65 ft.  
 WELL WATER TO BE USED AS: 5 Public water supply 8 Air conditioning 11 Injection well  
 1 Domestic 3 Feedlot 6 Oil field water supply 9 Dewatering 12 Other (Specify below)  
 2 Irrigation 4 Industrial 7 Domestic (lawn & garden) 10 Monitoring well  
 Was a chemical/bacteriological sample submitted to Department? Yes. No. X; If yes, mo/day/yr sample was submitted  
 Water Well Disinfected? Yes X No

5 TYPE OF BLANK CASING USED: 2 PVC 5 Wrought iron 8 Concrete tile CASING JOINTS: Glued. X Clamped.  
 1 Steel 3 RMP (SR) 6 Asbestos-Cement 9 Other (specify below) Welded  
 4 ABS 7 Fiberglass Threaded  
 Blank casing diameter 5 in. to 45 ft., Dia. 5 in. to 45 ft., Dia. 5 in. to 45 ft.  
 Casing height above land surface 24 in., weight 2.29 lbs./ft. Wall thickness or gauge No. 26  
 TYPE OF SCREEN OR PERFORATION MATERIAL: 7 PVC 10 Asbestos-cement  
 1 Steel 3 Stainless steel 5 Fiberglass 8 RMP (SR) 11 Other (specify)  
 2 Brass 4 Galvanized steel 6 Concrete tile 9 ABS 12 None used (open hole)  
 SCREEN OR PERFORATION OPENINGS ARE: 8 8 Saw cut 11 None (open hole)  
 1 Continuous slot 3 Mill slot 6 Wire wrapped 9 Drilled holes  
 2 Louvered shutter 4 Key punched 7 Torch cut 10 Other (specify) 8 Saw cut  
 SCREEN-PERFORATED INTERVALS: From 65 ft. to 45 ft., From 65 ft. to 45 ft.  
 From 65 ft. to 45 ft., From 65 ft. to 45 ft.  
 GRAVEL PACK INTERVALS: From 20 ft. to 65 ft., From 20 ft. to 65 ft.  
 From 20 ft. to 65 ft., From 20 ft. to 65 ft.

6 GROUT MATERIAL: 3 3 Bentonite 4 Other  
 1 Neat cement 2 Cement grout  
 Grout Intervals: From 0 ft. to 20 ft., From 0 ft. to 20 ft., From 0 ft. to 20 ft.  
 What is the nearest source of possible contamination:  
 1 Septic tank 4 Lateral lines 7 Pit privy 10 Livestock pens 14 Abandoned water well  
 2 Sewer lines 5 Cess pool 8 Sewage lagoon 11 Fuel storage 15 Oil well/Gas well  
 3 Watertight sewer lines 6 Seepage pit 9 Feedyard 12 Fertilizer storage 16 Other (specify below)  
 13 Insecticide storage  
 Direction from well? How many feet?

FROM	TO	LITHOLOGIC LOG	FROM	TO	PLUGGING INTERVALS
0	2	Topsoil			
2	10	Gumbo			
10	12	Sand			
12	25	Gumbo			
25	26	Gray clay			
26	30	Fine sand			
30	40	Gumbo			
40	43	Fine sand			
43	46	Rock			
46	54	Sand			
54	65	Shale			

7 CONTRACTOR'S OR LANDOWNER'S CERTIFICATION: This water well was (1) constructed, (2) reconstructed, or (3) plugged under my jurisdiction and was completed on (mo/day/year) 7/26/01 and this record is true to the best of my knowledge and belief. Kansas Water Well Contractor's Licence No. 199 This Water Well Record was completed on (mo/day/yr) 7/31/01 under the business name of Karst Water Well Drilling & Service, Inc. by (signature) *Mel Karst*