WATER WELL RECORD Form WWC-5 KSA 82a-1212 ID No. TW-10-04

1 LOCATION OF WATER WELL: County: Ellis | Fraction: NW ¼ NE ¼ NE ¼ | Section Number: 8 | Township Number: T 13S S | Range Number: R 20 E/W

Distance and direction from nearest town or city street address of well if located within city?
35' East of Well #10

2 WATER WELL OWNER: CITY OF ELLIS
RR#, St. Address, Box # : 815 Jefferson
City, State, ZIP Code : Ellis, KS 67637
Board of Agriculture, Division of Water Resources Application Number:

3 LOCATE WELL'S LOCATION WITH AN "X" IN SECTION BOX:

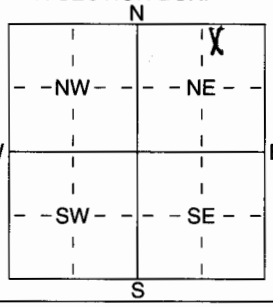

4 DEPTH OF COMPLETED WELL 42' ft. ELEVATION:
Depth(s) Groundwater Encountered 1 8.75 ft. 2 ft. 3 ft.
WELL'S STATIC WATER LEVEL 8.75 ft. below land surface measured on mo/day/yr
Pump test data: Well water was 23.80 ft. after 4 hours pumping 202 gpm
Est. Yield gpm: Well water was ft. after hours pumping gpm
WELL WATER TO BE USED AS: 1 Domestic 2 Irrigation 3 Feedlot 4 Industrial 5 Public water supply 6 Oil field water supply 7 Domestic (lawn & garden) 8 Air conditioning 9 Dewatering (10) Monitoring well 11 Injection well 12 Other (Specify below)

Was a chemical/bacteriological sample submitted to Department? Yes X No ; If yes, mo/day/yrs sample was submitted 5/26/04 Water Well Disinfected? Yes No

5 TYPE OF BLANK CASING USED: (2) PVC 1 Steel 3 RMP (SR) 4 ABS 5 Wrought iron 6 Asbestos-Cement 7 Fiberglass 8 Concrete tile 9 Other (specify below)
CASING JOINTS: Glued ✓ Clamped Welded Threaded
Blank casing diameter 6" in. to 27 ft., Dia 6" in. to 37-42 ft., Dia in. to ft.
Casing height above land surface 26 in., weight lbs./ft. Wall thickness or guage No.

TYPE OF SCREEN OR PERFORATION MATERIAL: (8) PVC 1 Steel 2 Brass 3 Stainless Steel 4 Galvanized Steel 5 Fiberglass 6 Concrete tile 8 RMP (SR) 9 ABS 10 Asbestos-Cement 11 Other (Specify) 12 None used (open hole)

SCREEN OR PERFORATION OPENINGS ARE: (1) Continuous slot 2 Louvered shutter 3 Mill slot 4 Key punched 5 Guazed wrapped 6 Wire wrapped 7 Torch cut 8 Saw cut 9 Drilled holes 10 Other (specify) 11 None (open hole)

SCREEN-PERFORATED INTERVALS: From 27 ft. to 37 ft., From ft. to ft.
From ft. to ft., From ft. to ft.
GRAVEL PACK INTERVALS: From 42 ft. to 25 ft., From ft. to ft.
From ft. to ft., From ft. to ft.

6 GROUT MATERIAL: 1 Neat cement 2 Cement grout (3) Bentonite 4 Other
Grout Intervals: From 0 ft. to 20 ft., From 24 ft. to 25 ft., From ft. to ft.

What is the nearest source of possible contamination:
1 Septic tank 2 Sewer lines 3 Watertight sewer lines 4 Lateral lines 5 Cess pool 6 Seepage pit 7 Pit privy 8 Sewage lagoon 9 Feedyard 10 Livestock pens 11 Fuel storage 12 Fertilizer storage 13 Insecticide storage 14 Abandoned water well 15 Oil well/Gas well 16 Other (specify below) None Known
Direction from well? How many feet?

FROM	TO	LITHOLOGIC LOG	FROM	TO	PLUGGING INTERVALS
0	1.5	Brown Topsoil			
1.5	3.0	Brwn. clay			
3.0	21.0	Dark Brown soft silty clay			
21	25.5	Fine to very fine sand, trace clay			
25.5	36	Fine to med sand w/fines, limestone			
36	41	Coarse to med w/fines & limestone			
41	46	Grey shale			

7 CONTRACTOR'S OR LANDOWNER'S CERTIFICATION: This water well was (1) constructed, (2) reconstructed, or (3) plugged under my jurisdiction and was completed on (mo/day/year) 5/26/04 and this record is true to the best of my knowledge and belief. Kansas Water Well Contractor's Licence No 581 This Water Well Record was completed on (mo/day/yr) 7/26/04 under the business name of Layne Christensen Co. by (signature) Russell W Reddy

INSTRUCTIONS: Use typewriter or ball point pen. *PLEASE PRESS FIRMLY* and *PRINT* clearly. Please fill in blanks, underline or circle the correct answers. Send top three copies to Kansas Department of Health and Environment, Bureau of Water, Geology Section, 1000 SW Jackson St., Suite 420, Topeka, Kansas 66612-1367. Telephone 785-296-5522. Send one to WATER WELL OWNER and retain one for your records. Fee of $5.00 for each constructed well.