


1 LOCATION OF WATER WELL: County: **Ellis** Fraction: **SE 1/4 SW 1/4 NW 1/4** Section Number: **9** Township Number: **T 13 S** Range Number: **R 20 E/W**

Distance and direction from nearest town or city street address of well if located within city?
500 E. 10th, Ellis

2 WATER WELL OWNER: **Golden Belt Coop**
 RR#, St. Address, Box #: **PO Box 138** Board of Agriculture, Division of Water Resources
 City, State, ZIP Code: **Ellis, Kansas 67637** Application Number:

3 LOCATE WELL'S LOCATION WITH AN "X" IN SECTION BOX:

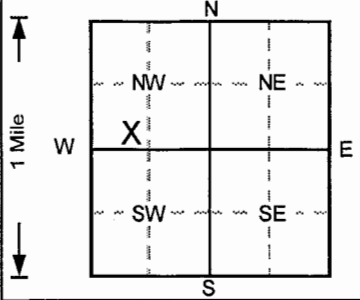

4 DEPTH OF COMPLETED WELL: **34** ft. ELEVATION: **2118.3**

Depth(s) Groundwater Encountered 1. ft. 2. ft. 3. ft.

WELL'S STATIC WATER LEVEL ... **22.3** ... ft. below land surface measured on **mo/day/yr** ... **10/5/2006**

Pump test data: Well water was ... **NA** ... ft. after ... hours pumping ... gpm

Est. Yield ... **NA** ... gpm: Well water was ... ft. after ... hours pumping ... gpm

Bore Hole Diameter ... **6** ... in. to ... **36** ... ft., and ... in. to ... ft.

WELL WATER TO BE USED AS: 5 Public water supply 8 Air conditioning 11 Injection well
 1 Domestic 3 Feedlot 6 Oil field water supply 9 Dewatering 12 Other (Specify below)
 2 Irrigation 4 Industrial 7 Lawn and garden only **10** Monitoring well

Was a chemical/bacteriological sample submitted to Department? Yes.....No ; If yes, mo/day/yr sample was submitted Water Well Disinfected? Yes No

5 TYPE OF BLANK CASING USED: 1 Steel 2 **PVC** 3 RMP (SR) 4 ABS 5 Wrought iron 6 Asbestos-Cement 7 Fiberglass 8 Concrete tile 9 Other (specify below) CASING JOINTS: Glued Clamped Welded Threaded

Blank casing diameter ... **2** ... in. to ... **14** ... ft., Dia ... in. to ... ft., Dia ... in. to ... ft.

Casing height above land surface ... **-4.8** ... in., weight ... lbs./ft. Wall thickness or gauge No. ... **Sch. 40**

TYPE OF SCREEN OR PERFORATION MATERIAL: 1 Steel 2 Brass 3 Stainless steel 4 Galvanized steel 5 Fiberglass 6 Concrete tile 7 **PVC** 8 RMP (SR) 9 ABS 10 Asbestos-cement 11 Other (specify) 12 None used (open hole)

SCREEN OR PERFORATION OPENINGS ARE: 1 Continuous slot 2 Louvered shutter 3 **Mill slot** 4 Key punched 5 Gauzed wrapped 6 Wire wrapped 7 Torch cut 8 Saw cut 9 Drilled holes 11 None (open hole) 10 Other (specify)

SCREEN-PERFORATED INTERVALS: From ... **14** ... ft. to ... **34** ... ft., From ... ft. to ... ft.

GRAVEL PACK INTERVALS: From ... **12** ... ft. to ... **36** ... ft., From ... ft. to ... ft.

6 GROUT MATERIAL: 1 Neat cement 2 Cement grout 3 **Bentonite** 4 **Other Concrete**

Grout Intervals: From ... **0** ... ft. to ... **1** ... ft., From ... **1** ... ft. to ... **14** ... ft., From ... ft. to ... ft.

What is the nearest source of possible contamination: 1 Septic tank 2 Sewer lines 3 Watertight sewer lines 4 Lateral lines 5 Cess pool 6 Seepage pit 7 Pit privy 8 Sewage lagoon 9 Feedyard 10 Livestock pens 11 Fuel storage 12 Fertilizer storage 13 Insecticide storage 14 Abandoned water well 15 Oil well/Gas well 16 Other (specify below)

Direction from well? How many feet?

FROM		TO		LITHOLOGIC LOG	FROM		TO		PLUGGING INTERVALS
0	5	0	5	Clay, silty, plastic, Dark Brown					
5	8.5	5	8.5	Clay, sl. silty, waxy, stiff, Grayish Brown					
8.5	15	8.5	15	Clay, silty, plastic, Lt. Brown					
15	19	15	19	Sand (f-c) w/tr. f gravel, sb rd-rd, varicolored					
19	34	19	34	Sand (f-c) w/f-c gravel, sb rd-rd, varicolored					
34	36	34	36	Shale, sl. weathered, Bluish Gray					

MW38, Flushmount
 Project Name: **Terranext - Golden Belt Coop**
 GeoCore # **1341**, #

7 CONTRACTOR'S OR LANDOWNER'S CERTIFICATION: This water well was **(1)** constructed, (2) reconstructed, or (3) plugged under my jurisdiction and was completed on (mo/day/year) ... **10/5/2006** ... and this record is true to the best of my knowledge and belief.
 Kansas Water Well Contractor's License No. ... **527** ... This Water Well Record was completed on (mo/day/yr) ... **10/9/2006** ... under the business name of **GeoCore, Inc.** by (signature) *John Kell*

INSTRUCTIONS: Use typewriter or ball point pen. PLEASE PRESS FIRMLY and PRINT clearly. Please fill in blanks, underline or circle the correct answers. Send top three copies to Kansas Department of Health and Environment, Bureau of Water, Topeka, Kansas 66620-0001. Telephone: 913-296-5545. Send one to WATER WELL OWNER and retain one for your records.