


1 LOCATION OF WATER WELL: County: Ellis	Fraction SE ¼ SW ¼ NW ¼	Section Number 9	Township Number T 13 S	Range Number R 20 EW
---	-----------------------------------	----------------------------	----------------------------------	---------------------------------------

Distance and direction from nearest town or city street address of well if located within city?
500 E. 10th, Ellis

2 WATER WELL OWNER: **Golden Belt Coop**
 RR#, St. Address, Box # : **PO Box 138**
 City, State, ZIP Code : **Ellis, Kansas 67637**
 Board of Agriculture, Division of Water Resources
 Application Number:

3 LOCATE WELL'S LOCATION WITH AN "X" IN SECTION BOX:

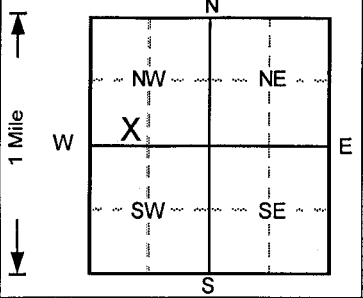

4 DEPTH OF COMPLETED WELL **35** ft. ELEVATION: **2117.27** ft.
 Depth(s) Groundwater Encountered 1. ft. 2. ft. 3. ft.
 WELL'S STATIC WATER LEVEL **20.9** ft. below land surface measured on mo/day/yr **10/5/2006**
 Pump test data: Well water was **NA** ft. after hours pumping gpm
 Est. Yield **NA** gpm: Well water was ft. after hours pumping gpm
 Bore Hole Diameter **6** in. to **35** ft., and in. to ft.
 WELL WATER TO BE USED AS: 5 Public water supply 8 Air conditioning 11 Injection well
 1 Domestic 3 Feedlot 6 Oil field water supply 9 Dewatering 12 Other (Specify below)
 2 Irrigation 4 Industrial 7 Lawn and garden only **10** Monitoring well
 Was a chemical/bacteriological sample submitted to Department? Yes.....No ; If yes, mo/day/yr sample was submitted
 Water Well Disinfected? Yes No

5 TYPE OF BLANK CASING USED: 5 Wrought iron 8 Concrete tile CASING JOINTS: Glued Clamped
 1 Steel 3 RMP (SR) 6 Asbestos-Cement 9 Other (specify below) Welded
2 PVC 4 ABS 7 Fiberglass Threaded.
 Blank casing diameter **2** in. to **13** ft., Dia in. to ft., Dia in. to ft.
 Casing height above land surface **4.92** in., weight lbs./ft. Wall thickness or gauge No. **Sch. 40**
 TYPE OF SCREEN OR PERFORATION MATERIAL **7** PVC 10 Asbestos-cement
 1 Steel 3 Stainless steel 5 Fiberglass 8 RMP (SR) 11 Other (specify)
 2 Brass 4 Galvanized steel 6 Concrete tile 9 ABS 12 None used (open hole)
 SCREEN OR PERFORATION OPENINGS ARE: 5 Gauzed wrapped 8 Saw cut 11 None (open hole)
 1 Continuous slot **3** Mill slot 6 Wire wrapped 9 Drilled holes
 2 Louvered shutter 4 Key punched 7 Torch cut 10 Other (specify)
 SCREEN-PERFORATED INTERVALS: From **13** ft. to **33** ft., From ft. to ft.
 From ft. to ft., From ft. to ft.
 GRAVEL PACK INTERVALS: From **11** ft. to **35** ft., From ft. to ft.
 From ft. to ft., From ft. to ft.

6 GROUT MATERIAL: 1 Neat cement 2 Cement grout **3** Bentonite **4** Other **Concrete**
 Grout Intervals: From **0** ft. to **1** ft., From **1** ft. to **11** ft., From ft. to ft.
 What is the nearest source of possible contamination:
 1 Septic tank 4 Lateral lines 7 Pit privy 10 Livestock pens 14 Abandoned water well
 2 Sewer lines 5 Cess pool 8 Sewage lagoon 11 Fuel storage 15 Oil well/Gas well
 3 Watertight sewer lines 6 Seepage pit 9 Feedyard 12 Fertilizer storage 16 Other (specify below)
 13 Insecticide storage
 Direction from well? How many feet?

FROM	TO	LITHOLOGIC LOG	FROM	TO	PLUGGING INTERVALS
0	5	Clay, silty, plastic, Dark Brown			
5	9	Clay, sl. silty, waxy, stiff, Grayish Brown			
9	16	Clay, v. silty, plastic, Lt. Brown			
16	20	Sand (f-c) w/f gravel, sb rd-sb ang, varicolored			
20	27.5	Sand (f-c) w/f-c gravel, sb rd, varicolored			
27.5	33	Sand, as above,			
33	35	Shale, sl. weathered, Bluish Gray			
					MW39, Flushmount
					Project Name: Terranext - Golden Belt Coop
					GeoCore # 1341, #

7 CONTRACTOR'S OR LANDOWNER'S CERTIFICATION: This water well was **(1)** constructed, (2) reconstructed, or (3) plugged under my jurisdiction and was completed on (mo/day/year) **10/5/2006** and this record is true to the best of my knowledge and belief.
 Kansas Water Well Contractor's License No. **527** This Water Well Record was completed on (mo/day/yr) **10/9/2006**
 under the business name of **GeoCore, Inc.** by (signature) *Don Bell*

OFFICE USE ONLY
T
R
EW
SEC.