


1 LOCATION OF WATER WELL: County: <b>Ellis</b>	Fraction <b>NW ¼ NE ¼ SE ¼</b>	Section Number <b>8</b>	Township Number <b>T 13 S</b>	Range Number <b>R 20 E</b>
---	--------------------------------	-------------------------	-------------------------------	----------------------------

Distance and direction from nearest town or city street address of well if located within city?

**1000 Washington, Ellis, Kansas**

2 WATER WELL OWNER: <b>Stop 2 Shop</b> RR#, St. Address, Box # : <b>3502 Fairway</b> City, State, ZIP Code : <b>Hays, Kansas 67601</b>	Board of Agriculture, Division of Water Resources Application Number:
--	--

3 LOCATE WELL'S LOCATION WITH AN "X" IN SECTION BOX:

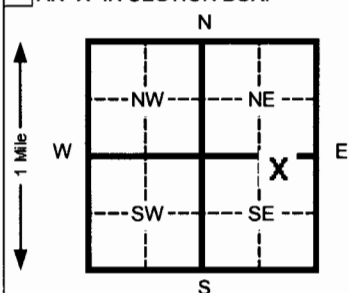

4 DEPTH OF COMPLETED WELL <b>25.0</b> ft. ELEVATION: _____	Depth(s) Groundwater Encountered 1 <b>18.0</b> ft. 2 _____ ft. 3 _____ ft.
WELL'S STATIC WATER LEVEL <b>13.40</b> ft. below land surface measured on mo/day/yr <b>04/08/07</b>	
Pump test data: Well water was _____ ft. after _____ hours pumping _____ gpm	
Est. Yield <b>NA</b> gpm: Well water was _____ ft. after _____ hours pumping _____ gpm	
Bore Hole Diameter <b>8.5</b> in. to <b>25.0</b> ft. and _____ in. to _____ ft.	
WELL WATER TO BE USED AS: 5 Public water supply 8 Air conditioning 11 Injection well	
1 Domestic 3 Feed lot 6 Oil field water supply 9 Dewatering 12 Other (Specify below)	
2 Irrigation 4 Industrial 7 Lawn and garden (domestic) <b>10</b> Monitoring well	
Was a chemical/bacteriological sample submitted to Department? Yes _____ No <b>X</b> If yes, mo/day/yr sample was submitted	
Water Well Disinfected? Yes _____ No <b>X</b>	

5 TYPE OF BLANK CASING USED:	5 Wrought Iron 8 Concrete tile	CASING JOINTS: Glued _____ Clamped _____
1 Steel 3 RMP (SR)	6 Asbestos-Cement 9 Other (specify below)	Welded _____
<b>2</b> PVC 4 ABS	7 Fiberglass	Threaded <b>X</b>
Blank casing diameter <b>2.375</b> in. to <b>10.0</b> ft., Dia _____ in. to _____ ft., Dia _____ in. to _____ ft.		
Casing height above land surface <b>Flush Mount</b> in., weight _____ lbs./ft. Wall thickness or gauge No. <b>Schedule 40</b>		
TYPE OF SCREEN OR PERFORATION MATERIAL:		
1 Steel 3 Stainless steel 5 Fiberglass 8 RMP (SR) 11 Other (specify) _____	<b>7</b> PVC 10 Asbestos-cement	
2 Brass 4 Galvanized steel 6 Concrete tile 9 ABS 12 None used (open hole)		
SCREEN OR PERFORATION OPENINGS ARE:		
1 Continuous slot <b>3</b> Mill slot 5 Gauzed wrapped 8 Saw cut 11 None (open hole)	6 Wire wrapped	9 Drilled holes
2 Louvered shutter 4 Key punched 7 Torch cut 10 Other (specify) _____		
SCREEN-PERFORATED INTERVALS: From <b>25.0</b> ft. to <b>10.0</b> ft. From _____ ft. to _____ ft.		
GRAVEL PACK INTERVALS: From <b>25.0</b> ft. to <b>8.0</b> ft. From _____ ft. to _____ ft.		

6 GROUT MATERIAL:	1 Neat cement <b>2</b> Cement grout <b>3</b> Bentonite 4 Other _____	Grout Intervals From <b>0.0</b> ft. to <b>0.5</b> ft. From <b>0.5</b> ft. to <b>8.0</b> ft. From _____ ft. to _____ ft.
What is the nearest source of possible contamination:		
1 Septic tank 4 Lateral lines 7 Pit privy <b>10</b> Livestock pens 14 Abandoned water well	2 Sewer lines 5 Cess pool 8 Sewage lagoon <b>11</b> Fuel storage 15 Oil well/ Gas well	3 Watertight sewer lines 6 Seepage pit 9 Feedyard 12 Fertilizer storage 16 Other (specify below)
Direction from well? <b>North</b>		How many feet? <b>320</b>

FROM	TO	CODE	LITHOLOGIC LOG
0.0	18.0		<b>Brown clayey silt, moist</b>
18.0	24.0		<b>Brown silty clay, wet</b>
24.0	25.0		<b>Light brown silty clay, slightly sandy, fine grained, wet</b>
<b>Exception to K.A.R. 28-30-6(b) (1) and (e) approved by D. Taylor, KDHE-BOW.</b>			

7 CONTRACTOR'S OR LANDOWNER'S CERTIFICATION: This water well was <b>1</b> constructed, (2) reconstructed, or (3) plugged under my jurisdiction and was completed on (mo/day/yr) <b>03/30/07</b> and this record is true to the best of my knowledge and belief. Kansas Water Well Contractor's License No. <b>692</b> This Water Well Record was completed on (mo/day/yr) <b>05/25/07</b> under the business name of <b>Quad State Services, Inc.</b> by (signature)
--

INSTRUCTIONS: Please fill in blanks and circle the correct answers. Send three copies to Kansas Department of Health and Environment, Bureau of Water, 1000 SW Jackson St., Ste. 420, Topeka, Kansas 66612-1367. Telephone: 913-296-5545. Send one to WATER WELL OWNER and retain one for your records.