


1 LOCATION OF WATER WELL: Fraction Section Number Township Number Range Number
 County: Ellis SE 1/4 SE 1/4 NE 1/4 8 13 20 **EW**

Distance and direction from nearest town or city street address of well if located within city?
1000 Washington Ellis KS

2 WATER WELL OWNER: Robert Gerstner
 RR #, St. Address, Box #: 3502 Fairway Board of Agriculture, Division of Water Resources
 City, State, ZIP Code: Hays KS 67601 Application Number:

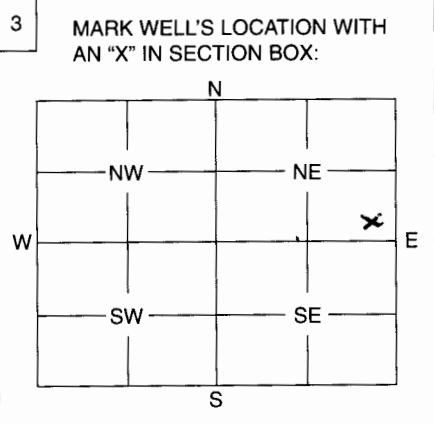

4 DEPTH OF WELL 19 ft.
 WELL'S STATIC WATER LEVEL Dry ft.
 WELL WAS USED AS:
 1 Domestic 2 Irrigation 3 Feedlot 4 Industrial 5 Public Water Supply 6 Oil Field Water Supply 7 Domestic (Lawn & Garden) 8 Air Conditioning 9 Dewatering 10 **Monitoring Well** 11 Injection Well 12 Other
 Was a chemical / bacteriological sample submitted to Department? Yes **No**
 If yes, mo/day/yr sample was submitted
 Water Well Disinfected: Yes **No**

5 TYPE OF BLANK CASING USED:
 1 Steel 2 **PVC** 3 RMP (SR) 4 ABS 5 Wrought 6 Asbestos-Cement 7 Fiberglass 8 Concrete Tile 9 Other (Specify below)
 Blank casing diameter 2 in. Was casing pulled? Yes **X** No If yes, how much 3 ft
 Casing height above or below land surface 3 in.

6 GROUT PLUG MATERIAL: 1 Neat cement 2 Cement grout 3 **Bentonite** 4 Other
 Grout Plug Intervals: From 19 ft. to 3 ft., From ft. to ft., From to ft.
 What is the nearest source of possible contamination:
 1 Septic tank 2 Sewer lines 3 Watertight sewer lines 4 Lateral lines 5 Cess pool 6 Seepage pit 7 Pit privy 8 Sewage lagoon 9 Feedyard 10 Livestock pens 11 **Fuel storage** 12 Fertilizer storage 13 Insecticide storage 14 Abandoned water well 15 Oil well/Gas well 16 Other (specify below)
 Direction from well? West How many feet? 170

FROM	TO	PLUGGING MATERIALS
<u>19</u>	<u>3</u>	<u>Bentonite</u>
<u>3</u>	<u>0</u>	<u>Soil</u>

7 CONTRACTOR'S OF LANDOWNER'S CERTIFICATION: This water well was plugged under my jurisdiction and was completed on (mo/day/year) 4-3-07 and this record is true to the best of my knowledge and belief. Kansas Water Well Contractor's license No. 6-2607 This Water Well Record was completed on (mo/day/year) under the business name of Salsteel Company by (signature) [Signature]

INSTRUCTIONS: Use typewriter or ball point pen. Please press firmly and print clearly. Please fill in blanks, underline or circle the correct answers. Send top three copies to Kansas Department of Health and Environment, Bureau of Water, Geology Section, 1000 SW Jackson St., Ste. 420, Topeka, Kansas 66612-1367. Telephone: 785/296-5522. Send one to Water Well Owner and retain one for your records.