


1	LOCATION OF WATER WELL:	Fraction	Section Number	Township Number	Range Number
	County: <u>Ellis</u>	<u>NW 1/4 NW 1/4 NE 1/4</u>	<u>8</u>	<u>13 5</u>	<u>20 W</u>

Distance and direction from nearest town or city street address of well if located within city?
South of 6th and Taylor

2 WATER WELL OWNER: City of Ellis
 RR#, St. Address, Box # 815 Jefferson Board of Agriculture, Division of Water Resources
 City, State, ZIP Code : Ellis, Kansas 67637 Application Number:

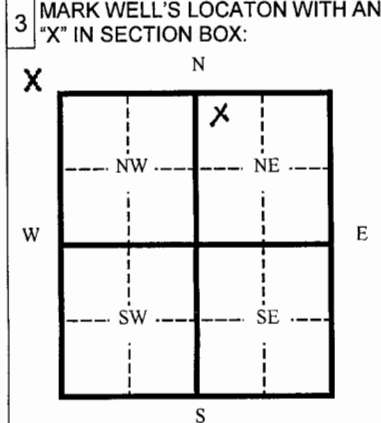

4 DEPTH OF WELL 47'6" ft.
 WELL'S STATIC WATER LEVEL 12'7" ft.
 WELL WAS USED AS:

1 Domestic	<u>5 Public Water Supply</u>	9 Dewatering
2 Irrigation	6 Oil Field Water Supply	10 Monitoring Well
3 Feedlot	7 Lawn and Garden (domestic)	11 Injection Well
4 Industrial	8 Air Conditioning	12 Other _____

Was a chemical/bacteriological sample submitted to Department? Yes ___ No XX
 If yes, mo/day/yr sample was submitted _____
 Water Well Disinfected: Yes XX No _____

5 TYPE OF BLANK CASING USED:

<u>Steel</u>	3 RMP (SR)	5 Wrought	7 Fiberglass	9 Other (specify below)
2 PVC	4 ABC	6 Asbestos-Cement	8 Concrete Tile	

Blank casing diameter 12 in. Was casing pulled? Yes XX No _____ If yes, how much 3' BGS
 Casing height above or below land surface 36" in.

6 GROUT PLUG MATERIAL: 1 Neat cement 2 Cement grout 3 Bentonite 4 Other _____
 Grout Plug Intervals From 25 ft. to 3 ft. From _____ ft. to _____ ft. From _____ ft. to _____ ft.
 What is the nearest source of possible contamination:

1 Septic tank	6 Seepage pit	11 Fuel storage	<u>16</u> Other (specify below)
2 Sewer lines	7 Pit privy	12 Fertilizer storage	<u>None Known</u>
3 Watertight sewer lines	8 Sewage lagoon	13 Insecticide storage	
4 Lateral lines	9 Feedyard	14 Abandoned water well	
5 Cess Pool	10 Livestock pens	15 Oil well/ Gas well	

Direction from well? _____ How many feet? _____

FROM	TO	CODE	PLUGGING MATERIALS
47'6"	25'		Clorinated Sand
25'	3'		Cement Grout
3'	0'		Topsoil

7 CONTRACTOR'S OR LANDOWNER'S CERTIFICATION: This water well was plugged under my jurisdiction and was completed on (mo/day/yr) December 15, 2008 and this record is true to the best of my knowledge and belief. Kansas Water Well Contractor's License No. 102 This Water Well Record was completed on (mo/day/yr) _____ under the business name of Layne Christensen Company by (signature) Russell W. Reddy

INSTRUCTIONS: Please fill in blanks and circle the correct answers. Send three copies to Kansas Department of Health and Environment, Bureau of Water, 1000 S W Jackson St., Ste. 420, Topeka, Kansas 66620-0001. Telephone: 785-296-3565. Send one to Water Well Owner and retain one for your records.