


1	LOCATION OF WATER WELL: Fraction	Section Number	Township Number	Range Number
County: <u>Ellis</u>	<u>NW 1/4 NW 1/4 NE 1/4</u>	<u>8</u>	<u>13 5</u>	<u>20 W</u>

Distance and direction from nearest town or city street address of well if located within city?  
South of 6th and Taylor

2 WATER WELL OWNER: City of Ellis  
 RR#, St. Address, Box # 815 Jefferson Board of Agriculture, Division of Water Resources  
 City, State, ZIP Code : Ellis, Kansas 67637 Application Number:

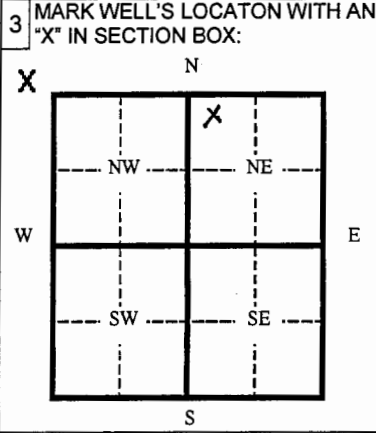

4 DEPTH OF WELL 47' 6" ft.  
 WELL'S STATIC WATER LEVEL 12' 7" ft.  
 WELL WAS USED AS:  
 1 Domestic      5 Public Water Supply      9 Dewatering  
 2 Irrigation      6 Oil Field Water Supply      10 Monitoring Well  
 3 Feedlot      7 Lawn and Garden (domestic)      11 Injection Well  
 4 Industrial      8 Air Conditioning      12 Other \_\_\_\_\_  
 Was a chemical/bacteriological sample submitted to Department? Yes \_\_\_ No XX  
 If yes, mo/day/yr sample was submitted \_\_\_\_\_  
 Water Well Disinfected: Yes XX No \_\_\_\_\_

5 TYPE OF BLANK CASING USED:  
 Steel      3 RMP (SR)      5 Wrought      7 Fiberglass      9 Other (specify below)  
 PVC      4 ABC      6 Asbestos-Cement      8 Concrete Tile  
 Blank casing diameter 12 in. Was casing pulled? Yes XX No \_\_\_\_\_ if yes, how much 3' BGS  
 Casing height above or below land surface 36" in.

6 GROUT PLUG MATERIAL: 1 Neat cement       Cement grout      3 Bentonite      4 Other \_\_\_\_\_  
 Grout Plug Intervals From 25 ft. to 3 ft. From \_\_\_\_\_ ft. to \_\_\_\_\_ ft. From \_\_\_\_\_ ft. to \_\_\_\_\_ ft.  
 What is the nearest source of possible contamination:  
 1 Septic tank      6 Seepage pit      11 Fuel storage       Other (specify below)  
 2 Sewer lines      7 Pit privy      12 Fertilizer storage      None Known  
 3 Watertight sewer lines      8 Sewage lagoon      13 Insecticide storage  
 4 Lateral lines      9 Feedyard      14 Abandoned water well  
 5 Cess Pool      10 Livestock pens      15 Oil well/ Gas well  
 Direction from well? \_\_\_\_\_ How many feet? \_\_\_\_\_

FROM	TO	CODE	PLUGGING MATERIALS
<u>47' 6"</u>	<u>25'</u>		<u>Clorinated Sand</u>
<u>25'</u>	<u>3'</u>		<u>Cement Grout</u>
<u>3'</u>	<u>0'</u>		<u>Topsoil</u>

7 CONTRACTOR'S OR LANDOWNER'S CERTIFICATION: This water well was plugged under my jurisdiction and was completed on (mo/day/yr) December 15, 2008 and this record is true to the best of my knowledge and belief. Kansas Water Well Contractor's License No. 102 This Water Well Record was completed on (mo/day/yr) \_\_\_\_\_ under the business name of Layne Christensen Company by (signature) Russell W. Kelly

INSTRUCTIONS: Please fill in blanks and circle the correct answers. Send three copies to Kansas Department of Health and Environment, Bureau of Water, 1000 S W Jackson St., Ste. 420, Topeka, Kansas 66620-0001. Telephone: 785-296-3565. Send one to Water Well Owner and retain one for your records.