


1 LOCATION OF WATER WELL: Fraction Section Number Township Number Range Number  
 County: Ellis NW 1/4 NE 1/4 NE 1/4 8 13 20 **NE NW**

Distance and direction from nearest town or city street address of well if located within city?  
North of 707 Jefferson, Ellis Kansas

2 WATER WELL OWNER: City of Ellis  
 RR #, St. Address, Box #: 815 Jefferson  
 City, State, ZIP Code: Ellis KS 67637  
 Board of Agriculture, Division of Water Resources  
 Application Number:

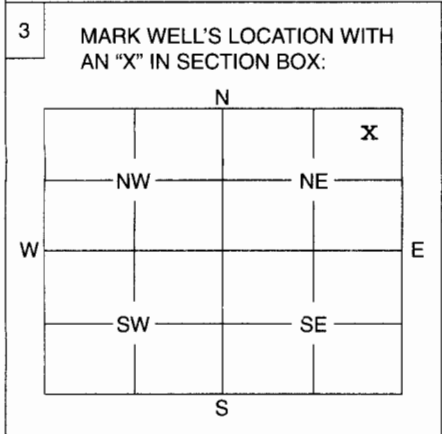

4 DEPTH OF WELL .....15..... ft.  
 WELL'S STATIC WATER LEVEL ....10..... ft.  
 WELL WAS USED AS:  
 1 Domestic  5 **Public Water Supply**  9 Dewatering   
 2 Irrigation  6 Oil Field Water Supply  10 Monitoring Well   
 3 Feedlot  7 Domestic (Lawn & Garden)  11 Injection Well   
 4 Industrial  8 Air Conditioning  12 Other .....  
 Was a chemical / bacteriological sample submitted to Department? Yes ..... No .....**Unknown**  
 If yes, mo/day/yr sample was submitted .....  
 Water Well Disinfected: Yes  No

5 TYPE OF BLANK CASING USED:  
 1 Steel 3 RMP (SR) 5 Wrought 7 Fiberglass 9 Other (Specify below)  
 2 PVC 4 ABS 6 Asbestos-Cement 8 Concrete Tile .....  
 Blank casing diameter ..... in. Was casing pulled? Yes ..... No  If yes, how much .....  
 Casing height above or below land surface ..... in.

6 GROUT PLUG MATERIAL: 1 Neat cement 2 Cement grout 3 Bentonite 4 Other .....  
 Grout Plug Intervals: From 0 ft. to 4 ft., From ..... ft. to ..... ft., From ..... to ..... ft.  
 What is the nearest source of possible contamination:  
 1 Septic tank 6 Seepage pit 11 Fuel storage 16 Other (specify below)  
 2 Sewer lines 7 Pit privy 12 Fertilizer storage .....  
 3 Watertight sewer lines 8 Sewage lagoon 13 Insecticide storage .....  
 4 Lateral lines 9 Feedyard 14 Abandoned water well .....  
 5 Cess pool 10 Livestock pens 15 Oil well/Gas well .....  
 Direction from well? ..... How many feet? .....

FROM	TO	PLUGGING MATERIALS
		<u>Chlorine, sand &amp; cement</u>

*Plugged by city maintenance workers in 1982.*

7 CONTRACTOR'S OF LANDOWNER'S CERTIFICATION: This water well was plugged under my jurisdiction and was completed on (mo/day/year) 1982 and this record is true to the best of my knowledge and belief. Kansas Water Well Contractor's License No. .... This Water Well Record was completed on (mo/day/year) 1/29/2009 under the business name of City of Ellis, 815 Jefferson, Ellis KS  
 by (signature) *[Signature]*

INSTRUCTIONS: Use typewriter or ball point pen. Please press firmly and print clearly. Please fill in blanks, underline or circle the correct answers. Send top three copies to Kansas Department of Health and Environment, Bureau of Water, Geology Section, 1000 SW Jackson St., Ste. 420, Topeka, Kansas 66612-1367. Telephone: 785/296-5522. Send one to Water Well Owner and retain one for your records.