

CORRECTION(S) TO WATER WELL RECORD (WWC-5)
(to rectify lacking or incorrect information)

County: Ellis

Location listed as:

Section-Township-Range: 7-11S-27W

Fraction (1/4 1/4 1/4): NW NE SW

Location changed to:

8-13S-20W

C SE NW

Other changes: Initial statements: _____

Changed to: _____

Comments: _____

verification method: Well site address, city street map, and mapping tool & aerial photos on KGS website.

initials: APL date: 10/30/2009


submitted by: Kansas Geological Survey, Data Resources Library, 1930 Constant Ave., Lawrence, KS 66047-3726
to: Kansas Dept of Health & Environment, Bureau of Water, 1000 SW Jackson, Suite 420, Topeka, KS 66612-1367.

1 LOCATION OF WATER WELL: Fraction **Ellis** **NW** $\frac{1}{4}$ **NE** $\frac{1}{4}$ **SW** $\frac{1}{4}$ Section Number **7** Township Number **T 11 S** Range Number **R 27 W E**

Distance and direction from nearest town or city street address of well if located within city?
West of pump Island

2 WATER WELL OWNER: **Les Weber**
RR#, St. Address, Box # : **715 W. 10th St.** Board of Agriculture, Division of Water Resources
City, State, ZIP Code : **Ellis, Ks 67637** Application Number:

3 LOCATE WELL'S LOCATION WITH AN "X" IN SECTION BOX:

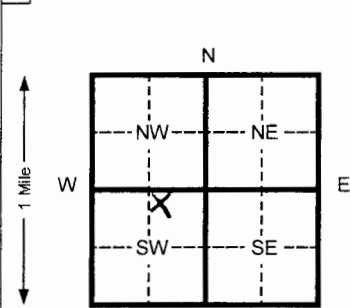

4 DEPTH OF COMPLETED WELL **23** ft. ELEVATION: _____
Depth(s) Groundwater Encountered _____ ft. 2 _____ ft. 3 _____ Ft.
WELL'S STATIC WATER LEVEL **NA** ft. below land surface measured on mo/day/yr _____
Pump test data: Well water was _____ Ft. after _____ hours pumping _____ Gpm
Est. Yield _____ Gpm: Well water was _____ Ft. after _____ Hours pumping _____ Gpm
Bore Hole Diameter **8.625** In. to **23** Ft. and _____ in. to _____ Ft.
WELL WATER TO BE USED AS: 5 Public water supply 8 Air conditioning 11 **Injection well**
1 Domestic 3 Feed lot 6 Oil field water supply 9 Dewatering 12 Other (Specify below)
2 Irrigation 4 Industrial 7 Lawn and garden (domestic) 10 Monitoring well **OI-8**
Was a chemical/bacteriological sample submitted to Department? Yes _____ No **X** If yes, mo/day/yr sample was Submitted _____
Water Well Disinfected? Yes _____ No **X**

5 TYPE OF BLANK CASING USED: 5 Wrought Iron 8 Concrete tile CASING JOINTS: Glued _____ Clamped _____
1 Steel 3 RMP (SR) 6 Asbestos-Cement 9 Other (specify below) Welded _____
2 **PVC** 4 ABS 7 Fiberglass _____ **Threaded** **X**

Blank casing diameter **1** in. to **21.5** Ft., Dia _____ in. to _____ Ft., Dia _____ in. to _____ ft.
Casing height above land surface **FLUSH** in., weight **SCH 40** Lbs./ft. Wall thickness or gauge No. _____

TYPE OF SCREEN OR PERFORATION MATERIAL: 7 **PVC** 10 Asbestos-cement
1 Steel 3 Stainless steel 5 Fiberglass 8 RMP (SR) 11 Other (specify) _____
2 Brass 4 Galvanized steel 6 Concrete tile 9 ABS 12 None used (open hole) _____

SCREEN OR PERFORATION OPENINGS ARE: 5 Gauzed wrapped 8 Saw cut 11 None (open hole)
1 Continuous slot 3 **Mill slot** 6 Wire wrapped 9 Drilled holes
2 Louvered shutter 4 Key punched 7 Torch cut 10 Other (specify) _____

SCREEN-PERFORATED INTERVALS: From **21.5** ft. to **23** ft. From _____ ft. to _____ ft.
From _____ ft. to _____ ft. From _____ ft. to _____ ft.
SAND PACK INTERVALS: From **20.5** ft. to **23** ft. From _____ ft. to _____ ft.
From _____ ft. to _____ ft. From _____ ft. to _____ ft.

6 GROUT MATERIAL: 1 Neat cement 2 Cement grout 3 **Bentonite** 4 Other _____

Grout intervals From 3 **18.5** ft. to **20.5** Ft. From 2 **1** Ft. to **18.5** ft. From _____ ft. to _____ ft.

What is the nearest source of possible contamination:
1 Septic tank 4 Lateral lines 7 Pit privy 10 Livestock pens 14 Abandoned water well
2 Sewer lines 5 Cess pool 8 Sewage lagoon 11 Fuel storage 15 Oil well/ Gas well
3 Watertight sewer lines 6 Seepage pit 9 Feedyard 12 Fertilizer storage 16 **Other (specify below)**
Contaminated Site

Direction from well? _____ How many feet? _____

FROM	TO	CODE	LITHOLOGIC LOG	FROM	TO	PLUGGING INTERVALS
0	.5		Gravel			
.5	21		Silty Clay			
21	23		Sand			
23	TD		END BOREHOLE			

7 CONTRACTOR'S OR LANDOWNER'S CERTIFICATION: This water well was (x) constructed, (2) reconstructed, or (3) plugged under my jurisdiction and was Completed on (mo/day/yr) **9/15/2009** And this record is true to the best of my knowledge and belief. Kansas Water Well Contractor's License No. **585** This Water Well Record was completed on (mo/day/yr) **10/12/2009** under the business name of **Associated Environmental, Inc.** By (signature) **Bradley J Johnson**

INSTRUCTIONS: Please fill in blanks and circle the correct answers. Send three copies to Kansas Department of Health and Environment, Bureau of Water, Topeka, Kansas 66620-0001. Telephone: 913-296-5545. Send one to WATER WELL OWNER and retain one for your records.

OFFICE USE ONLY