


1 LOCATION OF WATER WELL: Fraction Section Number Township Number Range Number
 County: ELLIS SW 1/4 SE 1/4 NE 1/4 8 13 S 20 W

Distance and direction from nearest town or city street address of well if located within city?
1000 WASHINGTON ST, ELLIS, KS, Southwest corner, 10th & 1/2

2 WATER WELL OWNER: STOP 2 SHOP, (ELLIS) Hickory
 RR #, St. Address, Box #: 3502 Fairway
 City, State, ZIP Code: HAYS KS 67601
 Board of Agriculture, Division of Water Resources
 Application Number:

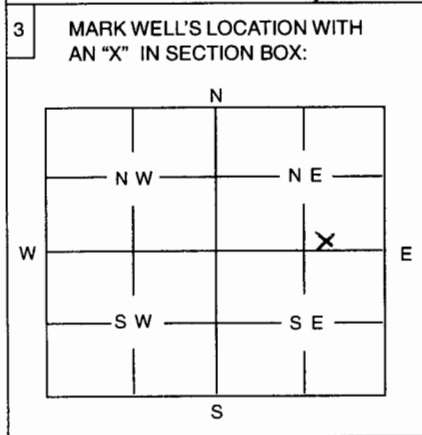

4 DEPTH OF WELL 25 ft
 WELL'S STATIC WATER LEVEL -13 ft
 NOTE: Well broke off @ screened level, 26' bgl. Presumably, the well was 29-30' TD.
 WELL WAS USED AS:
 1 Domestic 5 Public Water Supply 9 Dewatering
 2 Irrigation 6 Oil Field Water Supply 10 Monitoring Well
 3 Feedlot 7 Domestic (Lawn & Garden) 11 Injection Well
 4 Industrial 8 Air Conditioning 12 Other Remedial Test well
 Was a chemical / bacteriological sample submitted to Department? Yes No
 If yes, mo/day/yr sample was submitted
 Water Well Disinfected: Yes No Well removed during the soil excavation.

5 TYPE OF BLANK CASING USED:
 1 Steel 3 RMP (SR) 5 Wrought 7 Fiberglass 9 Other (Specify below)
2 PVC 4 ABS 6 Asbestos-Cement 8 Concrete Tile
 Blank casing diameter 4 in. Was casing pulled? Yes No If yes, how much 26'
 Casing height above or below land surface about 6 in. However, some screened portion remained.

6 GROUT PLUG MATERIAL: 1 Neat cement 2 Cement grout 3 Bentonite 4 Other Sand & Soil
 Grout Plug Intervals: From ~30 ft. to 26 ft., From 26 ft. to 5 ft., From 5 to 0 ft.
 What is the nearest source of possible contamination:
 1 Septic tank 6 Seepage pit 11 Fuel storage (former) 16 Other (specify below)
 2 Sewer lines 7 Pit privy 12 Fertilizer storage
 3 Watertight sewer lines 8 Sewage lagoon 13 Insecticide storage
 4 Lateral lines 9 Feedyard 14 Abandoned water well
 5 Cess Pool 10 Livestock pens 15 Oil well/Gas well
 Direction from well? S + SW How many feet? 20 MW-1R

FROM	TO	PLUGGING MATERIALS
<u>26</u>	<u>~30</u>	<u>Native saturated soil/sediment</u>
<u>5</u>	<u>26</u>	<u>Sand backfill</u>
<u>0</u>	<u>5</u>	<u>Clayey silt backfill</u>

NOTE 2: This monitoring/remedial test well was destroyed during soil excavation @ a L.U.S.T. clean-up site. All but the basal section of screen (4') was excavated. The former location of the well was backfilled with sand then capped with 5' of clayey silt.

7 CONTRACTOR'S OR LANDOWNER'S CERTIFICATION: This water well was plugged under my jurisdiction and was completed on (mo/day/year) 6-23-10 and this record is true to the best of my knowledge and belief. Kansas Water Well Contractor's License No. KDHE This Water Well Record was completed on (mo/day/year) 6-28-10 under the business name of KDHE NWDO
 by (signature) Dell Hinama, KDHE NWDO

INSTRUCTIONS: Use typewriter or ball point pen. Please press firmly and print clearly. Please fill in blanks, underline or circle the correct answers. Send top three copies to Kansas Department of Health and Environment, Bureau of Water, Topeka, Kansas 66620-0001. Telephone: 785/296-3565. Send one to Water Well Owner and retain one for your records.