


1	LOCATION OF WATER WELL: County: <u>ELLIS</u>	Fraction <u>SW 1/4 SE 1/4 NE 1/4</u>	Section Number <u>8</u>	Township Number <u>13S</u>	Range Number <u>20W</u>
---	---	---	----------------------------	-------------------------------	----------------------------

Distance and direction from nearest town or city street address of well if located within city?  
1000 WASHINGTON ST. ELLIS, KS SW corner, 10th + Washington

2	WATER WELL OWNER: <u>STOP 2 SHOP, (ELLIS)</u> RR #, St. Address, Box #: <u>3502 Fairway</u> City, State, ZIP Code: <u>HAYS KS 67601</u>	Board of Agriculture, Division of Water Resources Application Number:
---	---	--

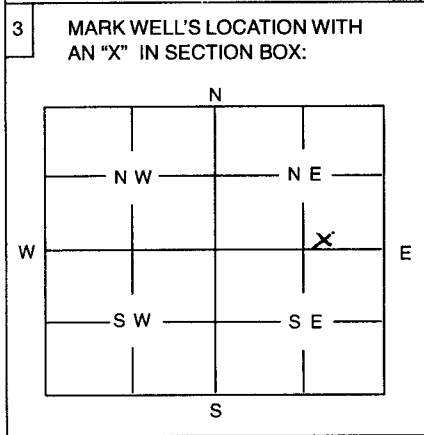

4 DEPTH OF WELL ..... 19 ft  
 WELL'S STATIC WATER LEVEL ..... 2/3 ft

WELL WAS USED AS:

1 Domestic	5 Public Water Supply	9 Dewatering
2 Irrigation	6 Oil Field Water Supply	<u>10</u> Monitoring Well
3 Feedlot	7 Domestic (Lawn & Garden)	11 Injection Well
4 Industrial	8 Air Conditioning	12 Other .....

Was a chemical / bacteriological sample submitted to Department? Yes ..... No   
 If yes, mo/day/yr sample was submitted .....

Water Well Disinfected: Yes ..... No  well was destroyed during removal of contaminated soil.

5 TYPE OF BLANK CASING USED:

1 Steel	3 RMP (SR)	5 Wrought	7 Fiberglass	9 Other (Specify below)
<u>2 PVC</u>	4 ABS	6 Asbestos-Cement	8 Concrete Tile	

Blank casing diameter ..... 2 in. Was casing pulled? Yes  No ..... If yes, how much all 19'  
 Casing height above or below land surface ..... 6 in.

6 GROUT PLUG MATERIAL: 1 Neat cement 2 Cement grout 3 Bentonite 4 Other Sand + Silt

Grout Plug Intervals: From 19 ft. to 5 ft., From 5 ft. to 0 ft., From ..... to ..... ft.

What is the nearest source of possible contamination:

1 Septic tank	6 Seepage pit	<u>11</u> Fuel storage (former)	16 Other (specify below)
2 Sewer lines	7 Pit privy	12 Fertilizer storage	
3 Watertight sewer lines	8 Sewage lagoon	13 Insecticide storage	
4 Lateral lines	9 Feedyard	14 Abandoned water well	
5 Cess Pool	10 Livestock pens	15 Oil well/Gas well	

Direction from well? ..... S + E How many feet? ..... 10

FROM	TO	PLUGGING MATERIALS
<u>19</u>	<u>5</u>	<u>Sand backfill</u>
<u>5</u>	<u>0</u>	<u>Compacted clayey silt</u>

Note: This well, MW-8, was removed in the process of removal of contaminated soil at a L.U.S.T. site. The former location of the well was backfilled with sand, then capped with 5' of compacted clayey silt.

7 CONTRACTOR'S OR LANDOWNER'S CERTIFICATION: This water well was plugged under my jurisdiction and was completed on (mo/day/year) ..... 6-22-10 ..... and this record is true to the best of my knowledge and belief. Kansas Water Well Contractor's License No. KDHE This Water Well Record was completed on (mo/day/year) 6-22-10 under the business name of KDHE NWDO by (signature) Bill Tolimano, KDHE NWDO