

WATER WELL RECORD Form WWC-5 KSA 82a-1212

1 LOCATION OF WATER WELL: Fraction NW 1/4 SE 1/4 NW 1/4 Section Number 8 Township Number T 13 S Range Number R 20 EW
 County: Ellis

Distance and direction from nearest town or city street address of well if located within city?

706 West 10th, Ellis, KS

2 WATER WELL OWNER: James & Alberts Wolf Trust


RR#, St. Address, Box #: 702 W. 10th

Board of Agriculture, Division of Water Resources

City, State, ZIP Code: Ellis, KS

Application Number:

3 LOCATE WELL'S LOCATION WITH AN "X" IN SECTION BOX:

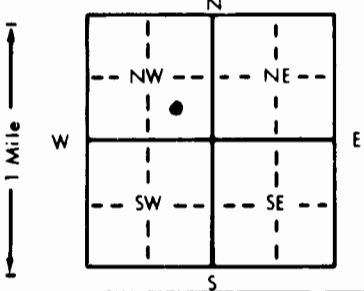

4 DEPTH OF COMPLETED WELL: 20' ft. ELEVATION:

Depth(s) Groundwater Encountered 1. 10' ft. 2. ft. 3. ft.

WELL'S STATIC WATER LEVEL: 9.59' ft. below land surface measured on mo/day/yr 5-1-98

Pump test data: Well water was ft. after hours pumping gpm

Est. Yield gpm; Well water was ft. after hours pumping gpm

Bore Hole Diameter: 8 1/2" in. to 20' ft., and in. to ft.

WELL WATER TO BE USED AS: 5 Public water supply 8 Air conditioning 11 Injection well

1 Domestic 3 Feedlot 6 Oil field water supply 9 Dewatering Other (Specify below)

2 Irrigation 4 Industrial 7 Lawn and garden only Monitoring well

Was a chemical/bacteriological sample submitted to Department? Yes No If yes, mo/day/yr sample was submitted

Water Well Disinfected? Yes No

5 TYPE OF BLANK CASING USED:

1 Steel 3 RMP (SR) 5 Wrought iron 8 Concrete tile CASING JOINTS: Glued Clamped

2 PVC 4 ABS 6 Asbestos-Cement 9 Other (specify below) Welded

Blank casing diameter 2.375 in. to 5' ft. Dia in. to ft. Dia in. to SDR 13 ft.

Casing height above land surface Flush Mt. in. weight lbs./ft. Wall thickness or gauge No. SCH. 40

TYPE OF SCREEN OR PERFORATION MATERIAL:

1 Steel 3 Stainless steel 5 Fiberglass 8 RMP (SR) 10 Asbestos-cement

2 Brass 4 Galvanized steel 6 Concrete tile 9 ABS 11 Other (specify)

SCREEN OR PERFORATION OPENINGS ARE: 5 Gauzed wrapped 8 Saw cut 11 None (open hole)

1 Continuous slot 3 Mill slot 6 Wire wrapped 9 Drilled holes

2 Louvered shutter 4 Key punched 7 Torch cut 10 Other (specify)

SCREEN-PERFORATED INTERVALS: From 20' ft. to 5' ft. From ft. to ft. From ft. to ft.

GRAVEL PACK INTERVALS: From 20' ft. to 4' ft. From ft. to ft. From ft. to ft.

6 GROUT MATERIAL: 1 Neat cement Cement grout Bentonite 4 Other

Grout Intervals: From 4' ft. to 3' ft. From 3' ft. to 0' ft. From ft. to ft.

What is the nearest source of possible contamination: 11 Fuel storage Funnel 14 Abandoned water well

1 Septic tank 4 Lateral lines 7 Pit privy 12 Fertilizer storage 15 Oil well/Gas well

2 Sewer lines 5 Cess pool 8 Sewage lagoon 13 Insecticide storage 16 Other (specify below)

3 Watertight sewer lines 6 Seepage pit 9 Feedyard

Direction from well? South East How many feet? 115'

FROM	TO	LITHOLOGIC LOG	FROM	TO	PLUGGING INTERVALS
0	1	Grass-top soil-blk			
1	6	Silty clay, brn-lt. brn at 5' soft, moist, mottled			
6	13	Sandy silty clay, brn soft, moist, fn-med grained sand well sorted			
13	17	Silty clay, gray-green, soft moist, high plastic, odor			
17	20	Clayey silt, green gray soft saturated, strong odor			

F.M. OK'd by N. Taylor

7 CONTRACTOR'S OR LANDOWNER'S CERTIFICATION: This water well was constructed reconstructed, or plugged under my jurisdiction and was completed on (mo/day/year) 4-21-98 and this record is true to the best of my knowledge and belief. Kansas

Water Well Contractor's License No. 539 This Water Well Record was completed on (mo/day/yr) 5-7-98

under the business name of JB Environmental Drilling by (signature) James Becker