


WATER WELL RECORD Form WWC-5 KSA 82a-1212

1 LOCATION OF WATER WELL: County: Ellis	Fraction SE 1/4 SE 1/4 NW 1/4	Section Number 8	Township Number T 13 S	Range Number R 20 EW
--	----------------------------------	---------------------	---------------------------	-------------------------

Distance and direction from nearest town or city street address of well if located within city?  
706 West 10th, Ellis, KS

2 WATER WELL OWNER: James & Alberts Wolf Trust  
RR#, St. Address, Box #: 702 W. 10th  
City, State, ZIP Code: Ellis, KS  
Board of Agriculture, Division of Water Resources  
Application Number:

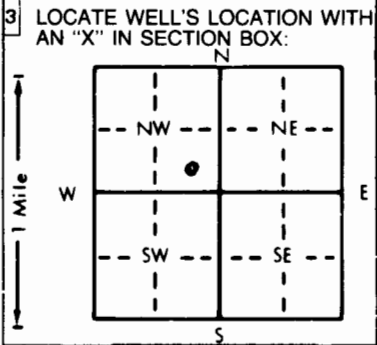

4 DEPTH OF COMPLETED WELL: 20' ft. ELEVATION:  
Depth(s) Groundwater Encountered: 1 10' ft. 2. ft. 3. ft.  
WELL'S STATIC WATER LEVEL: 9.95 ft. below land surface measured on mo/day/yr 5-1-98  
Pump test data: Well water was ... ft. after ... hours pumping ... gpm  
Est. Yield ... gpm; Well water was ... ft. after ... hours pumping ... gpm  
Bore Hole Diameter: 8 1/2" in. to 20' ft., and ... in. to ... ft.  
WELL WATER TO BE USED AS:  
5 Public water supply 8 Air conditioning 11 Injection well  
1 Domestic 3 Feedlot 6 Oil field water supply 9 Dewatering 12 Other (Specify below)  
2 Irrigation 4 Industrial 7 Lawn and garden only 10 Monitoring well  
Was a chemical/bacteriological sample submitted to Department? Yes ... No ... If yes, mo/day/yr sample was submitted  
Water Well Disinfected? Yes ... No

5 TYPE OF BLANK CASING USED:  
1 Steel 3 RMP (SR) 5 Wrought iron 8 Concrete tile CASING JOINTS: Glued ... Clamped ...  
2 PVC 4 ABS 6 Asbestos-Cement 9 Other (specify below) Welded ...  
7 Fiberglass Threaded ... X  
Blank casing diameter: 2.375 in. to 5' ft., Dia ... in. to ... ft., Dia ... in. to ... SDR 13 ft.  
Casing height above land surface: Flush Mt. in., weight ... lbs./ft. Wall thickness or gauge No. SCH 40  
TYPE OF SCREEN OR PERFORATION MATERIAL:  
1 Steel 3 Stainless steel 5 Fiberglass 8 RMP (SR) 10 Asbestos-cement  
2 Brass 4 Galvanized steel 6 Concrete tile 9 ABS 11 Other (specify) ...  
12 None used (open hole)  
SCREEN OR PERFORATION OPENINGS ARE:  
1 Continuous slot 3 Mill slot 5 Gauzed wrapped 8 Saw cut 11 None (open hole)  
2 Louvered shutter 4 Key punched 6 Wire wrapped 9 Drilled holes  
7 Torch cut 10 Other (specify) ...  
SCREEN-PERFORATED INTERVALS: From 20' ft. to 5' ft., From ... ft. to ... ft.  
GRAVEL PACK INTERVALS: From 20' ft. to 4' ft., From ... ft. to ... ft.

6 GROUT MATERIAL: 1 Neat cement 2 Cement grout 3 Bentonite 4 Other ...  
Grout Intervals: From 4' to 3' ft., From 3' to 0' ft., From ... ft. to ... ft.  
What is the nearest source of possible contamination:  
1 Septic tank 4 Lateral lines 7 Pit privy 10 Livestock pens 14 Abandoned water well  
2 Sewer lines 5 Cess pool 8 Sewage lagoon 11 Fuel storage FOUER 15 Oil well/Gas well  
3 Watertight sewer lines 6 Seepage pit 9 Feedyard 12 Fertilizer storage 16 Other (specify below)  
13 Insecticide storage  
Direction from well? East North East How many feet? 70'

FROM	TO	LITHOLOGIC LOG	FROM	TO	PLUGGING INTERVALS
0	.5	Concrete			
.5	14	Silty clay, dk brn. soft, moist, med. plastic At 10' silty clay as above, moist-sl wet			
14	18	Silty clay w/sand, Fn grained soft, wet, lt. brn-tan			
18	20	Sand, green, med-CSE grained well sorted rounded strong odor			

F.M. OK'd by D. Taylor

7 CONTRACTOR'S OR LANDOWNER'S CERTIFICATION: This water well was (1) constructed (2) reconstructed, or (3) plugged under my jurisdiction and was completed on (mo/day/year) 4-20-98 and this record is true to the best of my knowledge and belief. Kansas Water Well Contractor's License No. 539 This Water Well Record was completed on (mo/day/yr) 5-7-98 under the business name of JB Environmental Drilling by (signature) James Beebe

OFFICE USE ONLY  
T  
R  
EW  
SEC.  
1/4  
1/4  
1/4