

WATER WELL RECORD Form WWC-5 KSA 82a-1212

1 LOCATION OF WATER WELL: County: <b>Ellis</b>	Fraction <b>SE 1/4 SE 1/4 NW 1/4</b>	Section Number <b>8</b>	Township Number T <b>13</b> S	Range Number R <b>20</b> E <b>(W)</b>
---	---	----------------------------	----------------------------------	--

Distance and direction from nearest town or city street address of well if located within city?

706 West 10th, Ellis, KS

2 WATER WELL OWNER: **James & Alberts Wolf Trust**


RR#, St. Address, Box # : **702 W. 10th**

Board of Agriculture, Division of Water Resources

City, State, ZIP Code : **Ellis, KS**

Application Number:

3 LOCATE WELL'S LOCATION WITH AN "X" IN SECTION BOX:

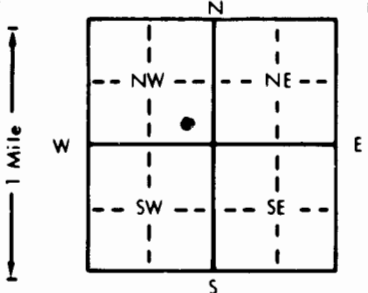

4 DEPTH OF COMPLETED WELL: **20'** ft. ELEVATION:

Depth(s) Groundwater Encountered 1. **10'** ft. 2. ft. 3. ft.

WELL'S STATIC WATER LEVEL: **9.6'** ft. below land surface measured on mo/day/yr

Pump test data: Well water was ft. after hours pumping gpm

Est. Yield gpm: Well water was ft. after hours pumping gpm

Bore Hole Diameter: **8 1/2"** in. to **20"** ft., and in. to ft.

- WELL WATER TO BE USED AS:
- 5 Public water supply
  - 8 Air conditioning
  - 11 Injection well
  - 1 Domestic
  - 3 Feedlot
  - 6 Oil field water supply
  - 9 Dewatering
  - 12 Other (Specify below)
  - 2 Irrigation
  - 4 Industrial
  - 7 Lawn and garden only
  - 10 Monitoring well

Was a chemical/bacteriological sample submitted to Department? Yes No **X**; If yes, mo/day/yr sample was submitted Water Well Disinfected? Yes **(No)**

5 TYPE OF BLANK CASING USED:

- 1 Steel
- 2 **PVC**
- 3 RMP (SR)
- 4 ABS

- 5 Wrought iron
- 6 Asbestos-Cement
- 7 Fiberglass
- 8 Concrete tile
- 9 Other (specify below)

- CASING JOINTS: Glued Clamped Welded Threaded **X**

Blank casing diameter **2.375** in. to **5'** ft., Dia in. to ft., Dia in. to **SDR 13** ft.

Casing height above land surface **Flush Mt.** in. weight lbs./ft. Wall thickness or gauge No. **SCH 40**

TYPE OF SCREEN OR PERFORATION MATERIAL:

- 1 Steel
- 2 Brass
- 3 Stainless steel
- 4 Galvanized steel
- 3 **Mill slot**
- 4 Key punched

- 5 Fiberglass
- 6 Concrete tile
- 7 **PVC**
- 8 RMP (SR)
- 9 ABS

- 10 Asbestos-cement
- 11 Other (specify)
- 12 None used (open hole)

SCREEN OR PERFORATION OPENINGS ARE:

- 1 Continuous slot
- 2 Louvered shutter
- 3 **Mill slot**
- 4 Key punched
- 5 Gauzed wrapped
- 6 Wire wrapped
- 7 Torch cut
- 8 Saw cut
- 9 Drilled holes
- 10 Other (specify)
- 11 None (open hole)

SCREEN-PERFORATED INTERVALS: From **20'** ft. to **5'** ft., From ft. to ft., From ft. to ft.

GRAVEL PACK INTERVALS: From **20'** ft. to **4'** ft., From ft. to ft., From ft. to ft.

6 GROUT MATERIAL:

- 1 Neat cement
- 2 **Cement grout**
- 3 **Bentonite**
- 4 Other

Grout Intervals: From **4'** to **3'** ft., From **3'** to **0'** ft., From ft. to ft.

What is the nearest source of possible contamination:

- 1 Septic tank
- 2 Sewer lines
- 3 Watertight sewer lines
- 4 Lateral lines
- 5 Cess pool
- 6 Seepage pit
- 7 Pit privy
- 8 Sewage lagoon
- 9 Feedyard
- 10 Livestock pens
- 11 **Fuel storage FOUCEL**
- 12 Fertilizer storage
- 13 Insecticide storage
- 14 Abandoned water well
- 15 Oil well/Gas well
- 16 Other (specify below)

Direction from well? **North**

How many feet? **100'**

FROM	TO	LITHOLOGIC LOG	FROM	TO	PLUGGING INTERVALS
0	2	Grass, top-soil -blk			
2	4	Clay, dk brn, dry-sl, moist sl firm, oxides			
4	15	Silty clay, lt. brn soft, moist, oxide zones At 11' silty clay, lt. brn, moist-sl wet, as above silty clay, as above saturated at 13'			
15	17	Sand, blk CSE grained, saturated			
17	20	<b>pounded well sorted</b> Silty clay, brn, firm, saturated oxides, sl plastic			

*F.H. OK'd by D. Taylor*

7 CONTRACTOR'S OR LANDOWNER'S CERTIFICATION: This water well was (1) **constructed** (2) reconstructed, or (3) plugged under my jurisdiction and was completed on (mo/day/year) **4-20-98** and this record is true to the best of my knowledge and belief. Kansas

Water Well Contractor's License No. **539** This Water Well Record was completed on (mo/day/yr) **5-7-98**

under the business name of **JB Environmental Drilling** by (signature) *James Bepko*