


WATER WELL RECORD Form WWC-5 KSA 82a-1212

1 LOCATION OF WATER WELL: County: Ellis Fraction: SE 1/4 SE 1/4 NW 1/4 Section Number: 8 Township Number: T 13 S Range Number: R 20 E/W

Distance and direction from nearest town or city street address of well if located within city?  
706 West 10th, Ellis, KS

2 WATER WELL OWNER: James & Alberts Wolf Trust  
 RR#, St. Address, Box #: 702 W. 10th Board of Agriculture, Division of Water Resources  
 City, State, ZIP Code: Ellis, KS Application Number:

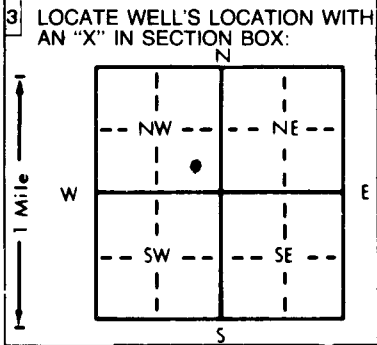

4 DEPTH OF COMPLETED WELL: 20' ft. ELEVATION: ..... ft.  
 Depth(s) Groundwater Encountered: 1. 12' ft. 2. .... ft. 3. .... ft.  
 WELL'S STATIC WATER LEVEL: 11.52' ft. below land surface measured on mo/day/yr 5-1-98  
 Pump test data: Well water was ..... ft. after ..... hours pumping ..... gpm  
 Est. Yield ..... gpm; Well water was ..... ft. after ..... hours pumping ..... gpm  
 Bore Hole Diameter: 8 1/2" in. to 20' ft., and ..... in. to ..... ft.  
 WELL WATER TO BE USED AS:  
 5 Public water supply 8 Air conditioning 11 Injection well  
 1 Domestic 3 Feedlot 6 Oil field water supply 9 Dewatering 12 Other (Specify below)  
 2 Irrigation 4 Industrial 7 Lawn and garden only 10 Monitoring well  
 Was a chemical/bacteriological sample submitted to Department? Yes ..... No X ..... If yes, mo/day/yr sample was submitted  
 Water Well Disinfected? Yes ..... No X .....

5 TYPE OF BLANK CASING USED:  
 1 Steel 3 RMP (SR) 5 Wrought iron 8 Concrete tile CASING JOINTS: Glued ..... Clamped .....  
2 PVC 4 ABS 6 Asbestos-Cement 9 Other (specify below) Welded .....  
 7 Fiberglass Threaded X  
 Blank casing diameter: 2.375 in. to 5' ft., Dia ..... in. to ..... ft., Dia ..... in. to SDR 13 ft.  
 Casing height above land surface: FLUSH Mt in., weight ..... lbs./ft. Wall thickness or gauge No. SCH 40  
 TYPE OF SCREEN OR PERFORATION MATERIAL:  
 1 Steel 3 Stainless steel 5 Fiberglass 8 RMP (SR) 10 Asbestos-cement  
 2 Brass 4 Galvanized steel 6 Concrete tile 9 ABS 11 Other (specify) .....  
 12 None used (open hole)  
 SCREEN OR PERFORATION OPENINGS ARE:  
 1 Continuous slot 3 Mill slot 5 Gauzed wrapped 8 Saw cut 11 None (open hole)  
 2 Louvered shutter 4 Key punched 6 Wire wrapped 9 Drilled holes  
 7 Torch cut 10 Other (specify) .....  
 SCREEN-PERFORATED INTERVALS: From 20' ft. to 5' ft., From ..... ft. to ..... ft.  
 From ..... ft. to ..... ft., From ..... ft. to ..... ft.  
 GRAVEL PACK INTERVALS: From 20' ft. to 4' ft., From ..... ft. to ..... ft.  
 From ..... ft. to ..... ft., From ..... ft. to ..... ft.

6 GROUT MATERIAL: 1 Neat cement 2 Cement grout 3 Bentonite 4 Other .....  
 Grout Intervals: From 4' ft. to 3' ft., From 2' ft. to 0' ft., From ..... ft. to ..... ft.  
 What is the nearest source of possible contamination:  
 1 Septic tank 4 Lateral lines 7 Pit privy 10 Livestock pens 14 Abandoned water well  
2 Sewer lines 5 Cess pool 8 Sewage lagoon 11 Fuel storage FUEL 15 Oil well/Gas well  
 3 Watertight sewer lines 6 Seepage pit 9 Feedyard 12 Fertilizer storage 16 Other (specify below)  
 13 Insecticide storage  
 Direction from well? EAD How many feet? 125'

FROM	TO	LITHOLOGIC LOG	FROM	TO	PLUGGING INTERVALS
0	8	Grass-dk-med brn silty clay w/trace amt. of caliche, dry, no odor			
8	10	Brn silty sand, fine-med. grained, dry, no odor			
10	16	Lt-med brn silty clay w/sand fine grained moist to wet, no odor, firm to soft			
16	20	Pale green fine-coarse sand, wet, slight odor, well graded			

*F.H. OK'd by Don Taylor*

7 CONTRACTOR'S OR LANDOWNER'S CERTIFICATION: This water well was (1) constructed, (2) reconstructed, or (3) plugged under my jurisdiction and was completed on (mo/day/year) 4-24-98 and this record is true to the best of my knowledge and belief. Kansas Water Well Contractor's License No. 539 This Water Well Record was completed on (mo/day/yr) 5-7-98 under the business name of JB Environmental Drilling by (signature) James Biebel

INSTRUCTIONS: Use typewriter or ball point pen. PLEASE PRESS FIRMLY and PRINT clearly. Please fill in blanks, underline or circle the correct answers. Send top three copies to Kansas Department of Health and Environment, Bureau of Water, Topeka, Kansas 66620-0001. Telephone: 913-296-5545. Send one to WATER WELL OWNER and retain one for your records.

OFFICE USE ONLY  
T  
R  
EW  
SEC.  
1/4  
1/4  
1/4