


WATER WELL RECORD Form WWC-5 KSA 82a-1212

1 LOCATION OF WATER WELL: County: <u>Ellis</u>	Fraction <u>SW</u> 1/4 <u>SW</u> 1/4 <u>NW</u> 1/4	Section Number <u>9</u>	Township Number T <u>13</u> S	Range Number R <u>20</u> E <u>W</u>
---	---	----------------------------	----------------------------------	--

Distance and direction from nearest town or city street address of well if located within city?
10th & Monroe, Ellis, Ks.

2 WATER WELL OWNER: Golden Belt Coop
 RR#, St. Address, Box #: 10th & Monroe
 City, State, ZIP Code: Ellis, Ks. 67637
 Board of Agriculture, Division of Water Resources
 Application Number:

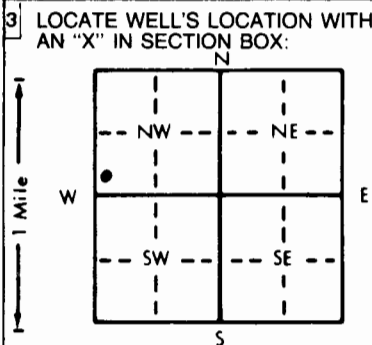

4 DEPTH OF COMPLETED WELL: 30' ft. ELEVATION: _____ ft.
 Depth(s) Groundwater Encountered: 1.4' ft. 2. _____ ft. 3. _____ ft.
 WELL'S STATIC WATER LEVEL: 12.30 ft. below land surface measured on mo/day/yr 6-4-98
 Pump test data: Well water was _____ ft. after _____ hours pumping _____ gpm
 Est. Yield _____ gpm Well water was _____ ft. after _____ hours pumping _____ gpm
 Bore Hole Diameter: 8 1/2" in. to 30' ft. and _____ in. to _____ ft.
 WELL WATER TO BE USED AS:
 5 Public water supply 8 Air conditioning 11 Injection well
 1 Domestic 3 Feedlot 6 Oil field water supply 9 Dewatering 12 Other (Specify below)
 2 Irrigation 4 Industrial 7 Lawn and garden only 10 Monitoring well
 Was a chemical/bacteriological sample submitted to Department? Yes _____ No X _____; If yes, mo/day/yr sample was submitted _____
 Water Well Disinfected? Yes _____ No (No) _____

5 TYPE OF BLANK CASING USED:
 1 Steel 3 RMP (SR) 5 Wrought iron 8 Concrete tile CASING JOINTS: Glued _____ Clamped _____
2 PVC 4 ABS 7 Fiberglass _____ Welded _____
 Blank casing diameter: 2.375 in. to 7' ft. Dia _____ in. to _____ ft. Dia _____ in. to SDR 13 ft.
 Casing height above land surface: Flush Mt. in. weight _____ lbs./ft. Wall thickness or gauge No. SCH 40
 TYPE OF SCREEN OR PERFORATION MATERIAL:
 1 Steel 3 Stainless steel 5 Fiberglass 8 RMP (SR) 10 Asbestos-cement 11 Other (specify) _____
 2 Brass 4 Galvanized steel 6 Concrete tile 9 ABS 12 None used (open hole)
 SCREEN OR PERFORATION OPENINGS ARE:
 1 Continuous slot 3 Mill slot 5 Gauzed wrapped 8 Saw cut 11 None (open hole)
 2 Louvered shutter 4 Key punched 6 Wire wrapped 9 Drilled holes
 7 Torch cut 10 Other (specify) _____
 SCREEN-PERFORATED INTERVALS: From 27' ft. to 7' ft. From _____ ft. to _____ ft. From _____ ft. to _____ ft.
 GRAVEL PACK INTERVALS: From 27' ft. to 5 1/2' ft. From _____ ft. to _____ ft. From _____ ft. to _____ ft.

6 GROUT MATERIAL: 1 Neat cement 2 Cement grout 3 Bentonite 4 Other Native fill
 Grout Intervals: From 5 1/2' ft. to 3' ft. From 3' ft. to 0' ft. From 30' ft. to 27' ft.
 What is the nearest source of possible contamination:
 1 Septic tank 4 Lateral lines 7 Pit privy 10 Livestock pens 14 Abandoned water well
 2 Sewer lines 5 Cess pool 8 Sewage lagoon 11 Fuel storage 15 Oil well/Gas well
 3 Watertight sewer lines 6 Seepage pit 9 Feedyard 12 Fertilizer storage 16 Other (specify below)
 13 Insecticide storage
 Direction from well? In Old AST Area How many feet? 0

FROM	TO	LITHOLOGIC LOG	FROM	TO	PLUGGING INTERVALS
0	1.5	Blk-dk brn clay, dry, no odor.			
1.5	7	Med brn silty clay, firm, damp, low-med plasticity, no odor.			
7	12	Lt green gray clayey silt to silty clay, moist-wet, soft.			
12	19	Gray fine silty sand to sand, wet at 13', strong odor.			
19	23.5	Blk clayey sand, wet, strong odor, fine grained sand.			
23.5	29	Tan-gray tan fine-med sand, w/ ls.rx.qtz., wet, no odor.			
29	30	Gray oxide stained shale, tight, dry, no odor.			

F.M. OK'd by Don Taylor

7 CONTRACTOR'S OR LANDOWNER'S CERTIFICATION: This water well was (1) constructed, (2) reconstructed, or (3) plugged under my jurisdiction and was completed on (mo/day/year) 539 and this record is true to the best of my knowledge and belief. Kansas Water Well Contractor's License No. JB Environmental Drilling This Water Well Record was completed on (mo/day/yr) _____ under the business name of _____ by (signature) James Becker

INSTRUCTIONS: Use typewriter or ball point pen. PLEASE PRESS FIRMLY and PRINT clearly. Please fill in blanks, underline or circle the correct answers. Send top three copies to Kansas Department of Health and Environment, Bureau of Water, Topeka, Kansas 66620-0001. Telephone: 913-296-5545. Send one to WATER WELL OWNER and retain one for your records.

OFFICE USE ONLY
T
R
EW
SEC
1/4
1/4
1/4