


1 LOCATION OF WATER WELL: County: Ellis Fraction SE 1/4 SE 1/4 NE 1/4 Section Number 8 Township Number T 13 S Range Number R 20 E/W

Distance and direction from nearest town or city street address of well if located within city?
10th & Monroe, Ellis

2 WATER WELL OWNER: Golden Belt Coop
 RR#, St. Address, Box #: 917 Monroe Board of Agriculture, Division of Water Resources
 City, State, ZIP Code: Ellis, Kansas 67637 Application Number:

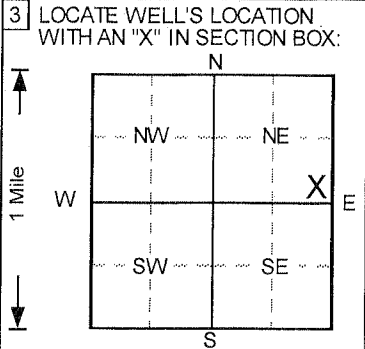

4 DEPTH OF COMPLETED WELL 30 ft. ELEVATION:
 Depth(s) Groundwater Encountered 1. ft. 2. ft. 3. ft.
 WELL'S STATIC WATER LEVEL ft. below land surface measured on mo/day/yr
 Pump test data: Well water was . . . NA . . . ft. after hours pumping gpm
 Est. Yield . . NA . . gpm: Well water was . . . ft. after hours pumping gpm
 Bore Hole Diameter . . . 8 . . in. to . . . 30 . . . ft., and in. to ft.
 WELL WATER TO BE USED AS: 5 Public water supply 8 Air conditioning 11 Injection well
 1 Domestic 3 Feedlot 6 Oil field water supply 9 Dewatering 12 Other (Specify below)
 2 Irrigation 4 Industrial 7 Lawn and garden only 10 Monitoring well Air sparge
 Was a chemical/bacteriological sample submitted to Department? Yes. No ; If yes, mo/day/yr sample was submitted
 Water Well Disinfected? Yes No

5 TYPE OF BLANK CASING USED:
 1 Steel 3 RMP (SR) 5 Wrought iron 8 Concrete tile CASING JOINTS: Glued Clamped
 2 PVC 4 ABS 7 Fiberglass Welded
 6 Asbestos-Cement 9 Other (specify below) Threaded.
 Blank casing diameter 2 in. to 28 ft., Dia. in. to ft., Dia. in. to ft.
 Casing height above land surface in., weight lbs./ft. Wall thickness or gauge No. Sch. 40
 TYPE OF SCREEN OR PERFORATION MATERIAL
 1 Steel 3 Stainless steel 5 Fiberglass 7 PVC 10 Asbestos-cement
 2 Brass 4 Galvanized steel 6 Concrete tile 8 RMP (SR) 11 Other (specify)
 9 ABS 12 None used (open hole)
 SCREEN OR PERFORATION OPENINGS ARE:
 1 Continuous slot 3 Mill slot 5 Gauzed wrapped 8 Saw cut 11 None (open hole)
 2 Louvered shutter 4 Key punched 6 Wire wrapped 9 Drilled holes
 7 Torch cut 10 Other (specify)
 SCREEN-PERFORATED INTERVALS: From 28 ft. to 30 ft., From ft. to ft.
 From ft. to ft., From ft. to ft.
 GRAVEL PACK INTERVALS: From 25 ft. to 30 ft., From ft. to ft.
 From ft. to ft., From ft. to ft.

6 GROUT MATERIAL: 1 Neat cement 2 Cement grout 3 Bentonite 4 Other
 Grout Intervals: From 5 ft. to 25 ft., From ft. to ft., From ft. to ft.
 What is the nearest source of possible contamination:
 1 Septic tank 4 Lateral lines 7 Pit privy 10 Livestock pens 14 Abandoned water well
 2 Sewer lines 5 Cess pool 8 Sewage lagoon 11 Fuel storage 15 Oil well/Gas well
 3 Watertight sewer lines 6 Seepage pit 9 Feedyard 12 Fertilizer storage 16 Other (specify below)
 13 Insecticide storage
 Direction from well? How many feet?

FROM	TO	LITHOLOGIC LOG	FROM	TO	PLUGGING INTERVALS
0	19	Open Hole,			
19	29	Sand, vf-c, w/f-c gravel, Lt. Gray Brown			
29	30	Clay, silty, Gray Brown			
					AS3, Flushmount

7 CONTRACTOR'S OR LANDOWNER'S CERTIFICATION: This water well was (1) constructed, (2) reconstructed, or (3) plugged under my jurisdiction and was completed on (mo/day/year) 7/22/2010 and this record is true to the best of my knowledge and belief.
 Kansas Water Well Contractor's License No. 527 This Water Well Record was completed on (mo/day/yr) 8/16/2010 under the business name of GeoCore, Inc. by (signature) Dan Kelly

OFFICE USE ONLY
T
R
EW
SEC.
1/4
1/4
1/4