


1 LOCATION OF WATER WELL: Fraction SW 1/4 SE 1/4 NE 1/4 Section Number 8 Township Number T 13 S Range Number R 20 E/W

Distance and direction from nearest town or city street address of well if located within city? 1000 Washington, Ellis

2 WATER WELL OWNER: Ellis Stop 2 Shop RR#, St. Address, Box #: 1000 Washington Board of Agriculture, Division of Water Resources City, State, ZIP Code: Ellis, Kansas 67637 Application Number:

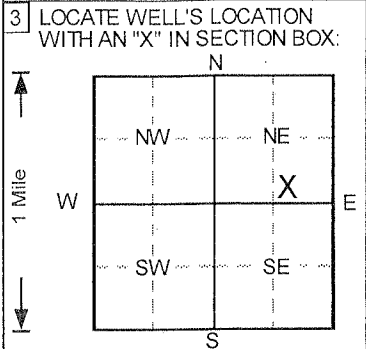

3 LOCATE WELL'S LOCATION WITH AN "X" IN SECTION BOX: 4 DEPTH OF COMPLETED WELL 25 ft. ELEVATION: 2120.32. WELL'S STATIC WATER LEVEL... Pump test data: Well water was NA ft. after... Est. Yield NA gpm... Bore Hole Diameter 8 in. to 25 ft... WELL WATER TO BE USED AS: 10 Monitoring well... Was a chemical/bacteriological sample submitted? Yes No checked; Water Well Disinfected? Yes No checked

5 TYPE OF BLANK CASING USED: 2 PVC 5 Wrought iron 8 Concrete tile CASING JOINTS: Glued Clamped Welded Threaded checked. Blank casing diameter 2 in. to 15 ft. Dia. Casing height above land surface -4.44 in., weight... TYPE OF SCREEN OR PERFORATION MATERIAL: 7 PVC 10 Asbestos-cement... SCREEN OR PERFORATION OPENINGS ARE: 3 Mill slot... SCREEN-PERFORATED INTERVALS: From 15 ft to 25 ft... GRAVEL PACK INTERVALS: From 13 ft to 25 ft

6 GROUT MATERIAL: 3 Bentonite 4 Other Concrete. Grout Intervals: From 0 ft to 1 ft, From 1 ft to 13 ft. What is the nearest source of possible contamination: 10 Livestock pens 14 Abandoned water well 15 Oil well/Gas well... Direction from well? How many feet?

LITHOLOGIC LOG table with columns FROM, TO, LITHOLOGIC LOG, FROM, TO, PLUGGING INTERVALS. Rows include Concrete, Clay, silty, Dark Brown, Clay, silty, Brown, Clay, v. silty, Brown, Clay, v. silty, V. Lt. Brown to Gray Brown, Clay, Lt. Gray, Clay, sl. sandy, Lt. Gray mottled Lt. Brown, Sand, vf, silty, Tan. MW11R, Flushmount

7 CONTRACTOR'S OR LANDOWNER'S CERTIFICATION: This water well was (1) constructed, (2) reconstructed, or (3) plugged under my jurisdiction and was completed on (mo/day/year) 8/5/2013 and this record is true to the best of my knowledge and belief. Kansas Water Well Contractor's License No. 527. This Water Well Record was completed on (mo/day/yr) 8/5/13 under the business name of GeoCore, Inc. by (signature) Dale Kelly