


1 LOCATION OF WATER WELL: County: Ellis Fraction: NE SW NW SW Section Number: 9 Township Number: T 13 S Range Number: R 20 E

Distance and direction from nearest town or city street address of well if located within city?  
406 E 13th Street Ellis KS 67637

2 WATER WELL OWNER: Dennis Bollig  
 RR#, St. Address, Box #: 406 E 13th Board of Agriculture, Division of Water Resources  
 City, State, ZIP Code: Ellis KS 67637 Application Number:

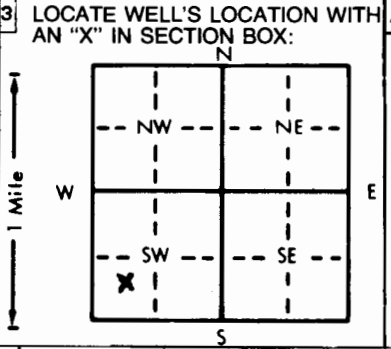

4 DEPTH OF COMPLETED WELL: 85 ft. ELEVATION:  
 Depth(s) Groundwater Encountered 1. 50 ft. 2. ft. 3. ft.  
 WELL'S STATIC WATER LEVEL 52 ft. below land surface measured on 5/10/82  
 Pump test data: Well water was 33 ft. after 1 1/2 hours pumping gpm  
 Est. Yield 20 gpm: Well water was ft. after hours pumping gpm  
 Bore Hole Diameter: 10 in. to ft., and in. to ft.  
 WELL WATER TO BE USED AS:  
 5 Public water supply 8 Air conditioning 11 Injection well  
 1 Domestic 3 Feedlot 6 Oil field water supply 9 Dewatering 12 Other (Specify below)  
 2 Irrigation 4 Industrial 7 Lawn and garden only 10 Observation well  
 Was a chemical/bacteriological sample submitted to Department? Yes No; If yes, mo/day/yr sample was submitted  
 Water Well Disinfected: Yes No

5 TYPE OF BLANK CASING USED:  
 1 Steel 3 RMP (SR) 5 Wrought iron 8 Concrete tile CASING JOINTS: Glued Clamped  
2 PVC 4 ABS 6 Asbestos-Cement 9 Other (specify below) Welded  
 7 Fiberglass Threaded  
 Blank casing diameter 5 in. to 6.5 in. Dia. Dia. in. to ft. Dia. in. to ft.  
 Casing height above land surface: 18 in., weight lbs./ft. Wall thickness or gauge No. SDR 26

TYPE OF SCREEN OR PERFORATION MATERIAL:  
 1 Steel 3 Stainless steel 5 Fiberglass 7 PVC 10 Asbestos-cement  
 2 Brass 4 Galvanized steel 6 Concrete tile 8 RMP (SR) 11 Other (specify)  
 9 ABS 12 None used (open hole)

SCREEN OR PERFORATION OPENINGS ARE:  
 1 Continuous slot 3 Mill slot 5 Gauzed wrapped 8 Saw cut 11 None (open hole)  
 2 Louvered shutter 4 Key punched 6 Wire wrapped 9 Drilled holes  
 7 Torch cut 10 Other (specify)

SCREEN-PERFORATED INTERVALS: From 6.5 ft. to 8.5 ft., From ft. to ft.  
 From ft. to ft., From ft. to ft.  
 GRAVEL PACK INTERVALS: From 6.9 ft. to 8.5 ft., From ft. to ft.  
 From ft. to ft., From ft. to ft.

6 GROUT MATERIAL: 1 Neat cement 2 Cement grout 3 Bentonite 4 Other  
 Grout Intervals: From 0 ft. to 12 ft., From ft. to ft., From ft. to ft.  
 What is the nearest source of possible contamination:  
 1 Septic tank 4 Lateral lines 7 Pit privy 10 Livestock pens 14 Abandoned water well  
2 Sewer lines 5 Cess pool 8 Sewage lagoon 11 Fuel storage 15 Oil well/Gas well  
3 Watertight sewer lines 6 Seepage pit 9 Feedyard 12 Fertilizer storage 16 Other (specify below)  
 13 Insecticide storage  
 Direction from well? South How many feet? 20

FROM	TO	LITHOLOGIC LOG	FROM	TO	LITHOLOGIC LOG
0	12	Top So. 1			
12	40	brown clay			
40	46	sand (fine/clear) mixed black mud (RIVER SOIL)			
46	71	brown clay			
71	83	SAND mixed with white GRAVEL			
83	85	shale			

7 CONTRACTOR'S OR LANDOWNER'S CERTIFICATION: This water well was 1 constructed, (2) reconstructed, or (3) plugged under my jurisdiction and was completed on (mo/day/year) 5/10/82 and this record is true to the best of my knowledge and belief. Kansas Water Well Contractor's License No. 276 This Water Well Record was completed on (mo/day/yr) 5/10/82 under the business name of LUSA Water Well by (signature) John Lusa

INSTRUCTIONS: Use typewriter or ball point pen, PLEASE PRESS FIRMLY and PRINT clearly. Please fill in blanks, underline or circle the correct answers. Send top three copies to Kansas Department of Health and Environment, Division of Environment, Environmental Geology Section, Topeka, KS 66620. Send one to WATER WELL OWNER and retain one for your records.

OFFICE USE ONLY

13 H 20

WMC

SEC

16

SW 1/4

SW 1/4

SW 1/4