


WATER WELL RECORD Form WWC-5 KSA 82a-1212

1 LOCATION OF WATER WELL: Fraction SW 1/4 SW 1/4 SE 1/4 Section Number 5 Township Number T 13 S Range Number R 20 EW

Distance and direction from nearest town or city street address of well if located within city?
501 West 6th, Ellis, KS.

2 WATER WELL OWNER: City of Ellis
RR#, St. Address, Box #: 501 W. 6th
City, State, ZIP Code: Ellis, Ks.
Board of Agriculture, Division of Water Resources
Application Number:

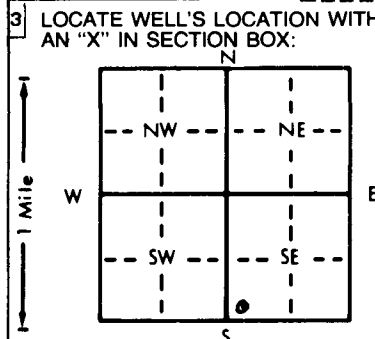

4 DEPTH OF COMPLETED WELL: 20' ft. ELEVATION:
Depth(s) Groundwater Encountered: 1. 9' ft. 2. ft. 3. ft.
WELL'S STATIC WATER LEVEL: 7.22 ft. below land surface measured on mo/day/yr 1-22-98
Pump test data: Well water was ft. after hours pumping gpm
Est. Yield gpm; Well water was ft. after hours pumping gpm
Bore Hole Diameter: 8 1/2" in. to 20' ft., and in. to ft.
WELL WATER TO BE USED AS:
5 Public water supply 8 Air conditioning 11 Injection well
1 Domestic 3 Feedlot 6 Oil field water supply 9 Dewatering 12 Other (Specify below)
2 Irrigation 4 Industrial 7 Lawn and garden only 10 Monitoring well
Was a chemical/bacteriological sample submitted to Department? Yes No X; If yes, mo/day/yr sample was submitted
Water Well Disinfected? Yes No

5 TYPE OF BLANK CASING USED:
1 Steel 3 RMP (SR) 5 Wrought iron 8 Concrete tile CASING JOINTS: Glued Clamped
2 PVC 4 ABS 6 Asbestos-Cement 9 Other (specify below) Welded
Blank casing diameter: 2.375 in. to 5' ft., Dia. in. to SDR 13 ft.
Casing height above land surface: Flush Mt. in., weight lbs./ft. Wall thickness or gauge No. SCH 40
TYPE OF SCREEN OR PERFORATION MATERIAL:
1 Steel 3 Stainless steel 5 Fiberglass 8 RMP (SR) 10 Asbestos-cement
2 Brass 4 Galvanized steel 6 Concrete tile 9 ABS 11 Other (specify)
12 None used (open hole)
SCREEN OR PERFORATION OPENINGS ARE:
1 Continuous slot 3 Mill slot 5 Gauzed wrapped 8 Saw cut 11 None (open hole)
2 Louvered shutter 4 Key punched 6 Wire wrapped 9 Drilled holes
3 SCREEN-PERFORATED INTERVALS: From 20' ft. to 5' ft., From ft. to ft.
GRAVEL PACK INTERVALS: From 20' ft. to 4' ft., From ft. to ft.

6 GROUT MATERIAL: 1 Neat cement 2 Cement grout 3 Bentonite 4 Other
Grout Intervals: From 4' to 2' ft., From 2' to 0' ft., From ft. to ft.
What is the nearest source of possible contamination:
1 Septic tank 4 Lateral lines 7 Pit privy 10 Livestock pens 14 Abandoned water well
2 Sewer lines 5 Cess pool 8 Sewage lagoon 11 Fuel storage 15 Oil well/Gas well
3 Watertight sewer lines 6 Seepage pit 9 Feedyard 12 Fertilizer storage 16 Other (specify below)
13 Insecticide storage
Direction from well? West with West How many feet? 125'

FROM	TO	LITHOLOGIC LOG	FROM	TO	PLUGGING INTERVALS
0	1	Grass-over ls.rx. gravel.			
1	9	Dk-med brn clay, dry to moist, no odor, firm.			
9	16.5	Moist to wet, dk-med brn clay, to sticky clay w/ caliche at 13', no odor, soft.			
16.5	20	Yellowish brn sand & gravel, fine-coarse sand, wet, no odor.			

FM OK'd by Don Taylor

7 CONTRACTOR'S OR LANDOWNER'S CERTIFICATION: This water well was (1) constructed (2) reconstructed, or (3) plugged under my jurisdiction and was completed on (mo/day/year) 1-20-98 and this record is true to the best of my knowledge and belief. Kansas Water Well Contractor's License No. 539 This Water Well Record was completed on (mo/day/yr) 2-13-98 under the business name of JB Environmental Drilling by (signature) James Beebe

OFFICE USE ONLY
T
R
EW
SEC
1/4
1/4
1/4