


WATER WELL RECORD Form WWC-5 KSA 82a-1212

1 LOCATION OF WATER WELL: Fraction SW 1/4 SW 1/4 SE 1/4 Section Number 5 Township Number T 13 S Range Number R 20 EW

Distance and direction from nearest town or city street address of well if located within city?
501 West 6th, Ellis, KS

2 WATER WELL OWNER: City of Ellis
 RR#, St. Address, Box #: 501 W. 6th Board of Agriculture, Division of Water Resources
 City, State, ZIP Code: Ellis, KS Application Number:

3 LOCATE WELL'S LOCATION WITH AN "X" IN SECTION BOX:

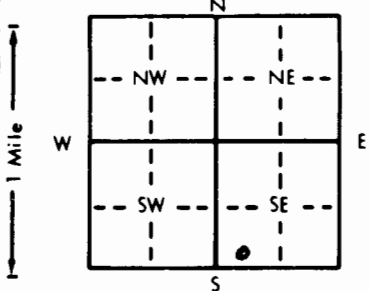

4 DEPTH OF COMPLETED WELL: 30' ft. ELEVATION:

Depth(s) Groundwater Encountered 1. 6' ft. 2. ft. 3. ft.
 WELL'S STATIC WATER LEVEL: 5.84' ft. below land surface measured on mo/day/yr 4-29-98
 Pump test data: Well water was ft. after hours pumping gpm
 Est. Yield gpm; Well water was ft. after hours pumping gpm
 Bore Hole Diameter: 8 1/2" in. to 30' ft. and in. to ft.
 WELL WATER TO BE USED AS:
 5 Public water supply 8 Air conditioning 11 Injection well
 1 Domestic 3 Feedlot 6 Oil field water supply 9 Dewatering 12 Other (Specify below)
 2 Irrigation 4 Industrial 7 Lawn and garden only 10 Monitoring well Obs. Well
 Was a chemical/bacteriological sample submitted to Department? Yes No X; If yes, mo/day/yr sample was submitted
 Water Well Disinfected? Yes No

5 TYPE OF CASING USED: 5 Wrought iron 8 Concrete tile CASING JOINTS: Glued Clamped

Blank casing diameter: 2.375 in. to 5' ft. Dia. in. to SDR 13 ft.
 Casing height above land surface: FLUSH HR. in., weight lbs./ft. Wall thickness or gauge No. SCH 40
 TYPE OF SCREEN OR PERFORATION MATERIAL:
 1 Steel 3 Stainless steel 5 Fiberglass 7 PVC 10 Asbestos-cement
 2 Brass 4 Galvanized steel 6 Concrete tile 8 RMP (SR) 11 Other (specify)
 12 None used (open hole)

SCREEN OR PERFORATION OPENINGS ARE:
 1 Continuous slot 3 Mill slot 5 Gauzed wrapped 8 Saw cut 11 None (open hole)
 2 Louvered shutter 4 Key punched 6 Wire wrapped 9 Drilled holes
 7 Torch cut 10 Other (specify)

SCREEN-PERFORATED INTERVALS: From 30' ft. to 5' ft. From ft. to ft.
 From ft. to ft. From ft. to ft.
 GRAVEL PACK INTERVALS: From 30' ft. to 4' ft. From ft. to ft.
 From ft. to ft. From ft. to ft.

6 GROUT MATERIAL: 1 Neat cement 2 Cement grout 3 Bentonite 4 Other

Grout Intervals: From 4' to 3' ft. From 3' to 0' ft. From ft. to ft.
 What is the nearest source of possible contamination:
 1 Septic tank 4 Lateral lines 7 Pit privy 10 Livestock pens 14 Abandoned water well
 2 Sewer lines 5 Cess pool 8 Sewage lagoon 11 Fuel storage 15 Oil well/Gas well
 3 Watertight sewer lines 6 Seepage pit 9 Feedyard 12 Fertilizer storage 16 Other (specify below)
 13 Insecticide storage
 Direction from well? East How many feet? 95'

FROM	TO	LITHOLOGIC LOG	FROM	TO	PLUGGING INTERVALS
0	4	Dk-med brn clay moist, no odor firm few Ls.Rx. gravelfrag			
4	9	Lt. grayish brn clayey sand w/ some silt moist to wet at 8' odor fine grained sand			
9	15	Gray fine-med grained sand blue gray sandy clay to clayey sand, soft, wet, med odor			
15	29	Gray fine-coarse grained sand w/Ls.Rx. gravel, wet, strong odor, well graded			
29	30	Dk gray shaley clay, dry, tight no odor			

F.M. OK'd by D. Taylor

7 CONTRACTOR'S OR LANDOWNER'S CERTIFICATION: This water well was (1) constructed (2) reconstructed, or (3) plugged under my jurisdiction and was completed on (mo/day/year) 4-23-98 and this record is true to the best of my knowledge and belief. Kansas Water Well Contractor's License No. 539 This Water Well Record was completed on (mo/day/year) 5-7-98 under the business name of JB Environmental Drilling by (signature) James Beebe

INSTRUCTIONS: Use typewriter or ball point pen. PLEASE PRESS FIRMLY and PRINT clearly. Please fill in blanks, underline or circle the correct answers. Send top three copies to Kansas Department of Health and Environment, Bureau of Water, Topeka, Kansas 66620-0001. Telephone: 913-296-5545. Send one to WATER WELL OWNER and retain one for your records.

OFFICE USE ONLY
T
R
EW
SEC
1/4
1/4
1/4