


WATER WELL RECORD Form WWC-5 KSA 82a-1212

1 LOCATION OF WATER WELL: County: Ellis Fraction SW $\frac{1}{4}$ SW $\frac{1}{4}$ SE $\frac{1}{4}$ Section Number 5 Township Number T 13 S Range Number R 20 EW (EW)

Distance and direction from nearest town or city street address of well if located within city?
501 West 6th, Ellis, KS

2 WATER WELL OWNER: City of Ellis
 RR#, St. Address, Box #: 501 W. 6th
 City, State, ZIP Code: Ellis, KS
 Board of Agriculture, Division of Water Resources
 Application Number:

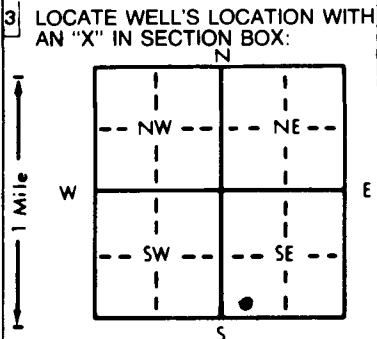

4 DEPTH OF COMPLETED WELL: 20' ft. ELEVATION: ft.
 Depth(s) Groundwater Encountered 1. 6' ft. 2. ft. 3. ft.
 WELL'S STATIC WATER LEVEL 5.75' ft. below land surface measured on mo/day/yr 4-29-98
 Pump test data: Well water was ft. after hours pumping gpm
 Est. Yield gpm; Well water was ft. after hours pumping gpm
 Bore Hole Diameter: 8 1/2" in. to 20' ft., and in. to ft.
 WELL WATER TO BE USED AS:
 1 Domestic 3 Feedlot 6 Oil field water supply 9 Dewatering 11 Injection well
 2 Irrigation 4 Industrial 7 Lawn and garden only Monitoring well obs. Well
 Was a chemical/bacteriological sample submitted to Department? Yes No X If yes, mo/day/yr sample was submitted
 Water Well Disinfected? Yes No (No)

5 TYPE OF CASING USED:
 1 Steel 3 RMP (SR) 5 Wrought iron 8 Concrete tile CASING JOINTS: Glued Clamped
2 PVC 4 ABS 6 Asbestos-Cement 9 Other (specify below) Welded
 Blank casing diameter 2.375 in. to 5' ft., Dia in. to ft., Dia in. to SDR 13 ft.
 Casing height above land surface Flush Mt. in., weight lbs./ft. Wall thickness or gauge No. SCH 40
 TYPE OF SCREEN OR PERFORATION MATERIAL:
 1 Steel 3 Stainless steel 5 Fiberglass 8 RMP (SR) 11 Other (specify)
 2 Brass 4 Galvanized steel 6 Concrete tile 9 ABS 12 None used (open hole)
 SCREEN OR PERFORATION OPENINGS ARE:
 1 Continuous slot 3 Mill slot 5 Gauzed wrapped 8 Saw cut 11 None (open hole)
 2 Louvered shutter 4 Key punched 6 Wire wrapped 9 Drilled holes
 SCREEN-PERFORATED INTERVALS: From 20' ft. to 5' ft., From ft. to ft.
 GRAVEL PACK INTERVALS: From 20' ft. to 4' ft., From ft. to ft.

6 GROUT MATERIAL: 1 Neat cement 2 Cement grout 3 Bentonite 4 Other
 Grout Intervals: From 4' to 3' ft., From 3' ft. to 0' ft., From ft. to ft.
 What is the nearest source of possible contamination:
 1 Septic tank 4 Lateral lines 7 Pit privy 11 Fuel storage 14 Abandoned water well
 2 Sewer lines 5 Cess pool 8 Sewage lagoon 12 Fertilizer storage 15 Oil well/Gas well
 3 Watertight sewer lines 6 Seepage pit 9 Feedyard 13 Insecticide storage 16 Other (specify below)
 Direction from well? Northeast How many feet? 140'

FROM	TO	LITHOLOGIC LOG	FROM	TO	PLUGGING INTERVALS
0	5	Dk-med brn silty clay to clay w/trace amt. of fine sand, dry no odor, firm			
5	8	Lt. brn clayey silt, soft, no odor high plasticity, moist to wet			
8	10	Gray clayey silty sand, wet mod odor, soft, fine grained sand			
10	20	Gray fine-coarse sand w/Ls. Rx. pebble size gravel wet, some silt lens strong odor			

F.H. OK'd by D. Taylor

7 CONTRACTOR'S OR LANDOWNER'S CERTIFICATION: This water well was (constructed) (2) reconstructed, or (3) plugged under my jurisdiction and was completed on (mo/day/year) 4-23-98 and this record is true to the best of my knowledge and belief. Kansas Water Well Contractor's License No. 539 This Water Well Record was completed on (mo/day/yr) 5-7-98 under the business name of JB Environmental Drilling by (signature) James Bieber

OFFICE USE ONLY

T

R

EW

SEC.

1/4

1/4

1/4