

**WATER WELL RECORD Form WWC-5**

Division of Water Resources App. No.

Well ID MW3

Original Record  Correction  Change in Well Use

<b>1 LOCATION OF WATER WELL:</b> County: ELLIS	Fraction NE ¼ SW ¼ NE ¼ SE ¼	Section Number 5	Township Number T 13 S	Range Number R 20 <input type="checkbox"/> E <input checked="" type="checkbox"/> W
---	---------------------------------	---------------------	---------------------------	---

<b>2 WELL OWNER:</b> Last Name: Haney First: Gerald Business: Love's Travel Shops Address: 10601 N. Pennsylvania City: Oklahoma City State: OK ZIP: 73120	Street or Rural Address where well is located (if unknown, distance and direction from nearest town or intersection): If at owner's address, check here: <input type="checkbox"/> 200 Washington St. Ellis, KS 67637
--	--

**3 LOCATE WELL WITH "X" IN SECTION BOX:**

N

NW	NE	SE	SW
			X

S

1 mile

**4 DEPTH OF COMPLETED WELL:** 50 ft.

Depth(s) Groundwater Encountered: 1) 43.5 ft.  
2) ..... ft. 3) ..... ft., or 4)  Dry Well

WELL'S STATIC WATER LEVEL: 40.42 ft.  
 below land surface, measured on (mo-day-yr) 3/24/21  
 above land surface, measured on (mo-day-yr) .....

Pump test data: Well water was ..... ft.  
after ..... hours pumping ..... gpm  
Well water was ..... ft.  
after ..... hours pumping ..... gpm

Estimated Yield: ..... gpm  
Bore Hole Diameter: 8.5 in. to 50 ft. and  
..... in. to ..... ft.

**5 Latitude:** 38.94748 (decimal degrees)  
**Longitude:** 99.56042 (decimal degrees)  
**Horizontal Datum:**  WGS 84  NAD 83  NAD 27  
**Source for Latitude/Longitude:**  
 GPS (unit make/model: .....)  
(WAAS enabled?  Yes  No)  
 Land Survey  Topographic Map  
 Online Mapper: .....

**6 Elevation:** 2135.16 ft.  Ground Level  TOC  
**Source:**  Land Survey  GPS  Topographic Map  
 Other .....

**7 WELL WATER TO BE USED AS:**

1. Domestic: <input type="checkbox"/> Household <input type="checkbox"/> Lawn & Garden <input type="checkbox"/> Livestock	5. <input type="checkbox"/> Public Water Supply: well ID .....	10. <input type="checkbox"/> Oil Field Water Supply: lease .....
2. <input type="checkbox"/> Irrigation	6. <input type="checkbox"/> Dewatering: how many wells? .....	11. Test Hole: well ID .....
3. <input type="checkbox"/> Feedlot	7. <input type="checkbox"/> Aquifer Recharge: well ID .....	<input type="checkbox"/> Cased <input type="checkbox"/> Uncased <input type="checkbox"/> Geotechnical
4. <input type="checkbox"/> Industrial	8. <input checked="" type="checkbox"/> Monitoring: well ID MW2	12. Geothermal: how many bores? .....
	9. Environmental Remediation: well ID .....	a) Closed Loop <input type="checkbox"/> Horizontal <input type="checkbox"/> Vertical
	<input type="checkbox"/> Air Sparge <input type="checkbox"/> Soil Vapor Extraction	b) Open Loop <input type="checkbox"/> Surface Discharge <input type="checkbox"/> Inj. of Water
	<input type="checkbox"/> Recovery <input type="checkbox"/> Injection	13. <input type="checkbox"/> Other (specify): .....

**Was a chemical/bacteriological sample submitted to KDHE?**  Yes  No If yes, date sample was submitted: .....

Water well disinfected?  Yes  No

**8 TYPE OF CASING USED:**  Steel  PVC  Other .....

Casing diameter 2 in. to 50 in. Diameter ..... in. to ..... ft., Diameter ..... in. to ..... ft.  
Casing height above land surface ..... in. Weight ..... lbs./ft. Wall thickness or gauge No. Sch 40

**TYPE OF SCREEN OR PERFORATION MATERIAL:**  
 Steel  Stainless Steel  Fiberglass  PVC  Other (Specify) .....

Brass  Galvanized Steel  Concrete tile  None used (open hole)

**SCREEN OR PERFORATION OPENINGS ARE:**  
 Continuous Slot  Mill Slot  Gauze Wrapped  Torch Cut  Drilled Holes  Other (Specify) .....

Louvered Shutter  Key Punched  Wire Wrapped  Saw Cut  None (Open Hole)

**SCREEN-PERFORATED INTERVALS:** From 35 ft. to 50 ft., From ..... ft. to ..... ft., From ..... ft. to ..... ft.  
**GRAVEL PACK INTERVALS:** From 33 ft. to 35 ft., From ..... ft. to ..... ft., From ..... ft. to ..... ft.

**9 GROUT MATERIAL:**  Neat cement  Cement grout  Bentonite  Other Concrete Surface Completion 0 - 1

Grout Intervals: From 1 ft. to 33 ft., From ..... ft. to ..... ft., From ..... ft. to ..... ft.

**Nearest source of possible contamination:**  
 Septic Tank  Lateral Lines  Pit Privy  Livestock Pens  Insecticide Storage  
 Sewer Lines  Cess Pool  Sewage Lagoon  Fuel Storage  Abandoned Water Well  
 Watertight Sewer Lines  Seepage Pit  Feedyard  Fertilizer Storage  Oil Well/Gas Well  
 Other (Specify) .....


Direction from well? West Distance from well? 30 ft.

10 FROM	TO	LITHOLOGIC LOG	FROM	TO	LITHO. LOG (cont.) or PLUGGING INTERVALS
0	0.5	Concrete (8")			
1	32	Silty Clay (CL), brown			
32	34	Sandy Clay (SC), brown			
34	50	Silty Clay (CL), brown			

**Notes:** KDHE Storage Tanks (LUST) LSA Addendum Project  
Love's Travel Stop #455, U6-026-15219, Ellis

**11 CONTRACTOR'S OR LANDOWNER'S CERTIFICATION:** This water well was  constructed,  reconstructed, or  plugged under my jurisdiction and was completed on (mo-day-year) 3/16/21 and this record is true to the best of my knowledge and belief. Kansas Water Well Contractor's License No. 585 This Water Well Record was completed on (mo-day-year) 4/17/21 under the business name of Associated Environmental, Inc. Signature *[Signature]*

Mail 1 white copy along with a fee of \$5.00 for each constructed well to: Kansas Department of Health and Environment, Bureau of Water, GWTS Section, 1000 SW Jackson St., Suite 420, Topeka, Kansas 66612-1367. Mail one to Water Well Owner and retain one for your records. Telephone 785-296-5524.

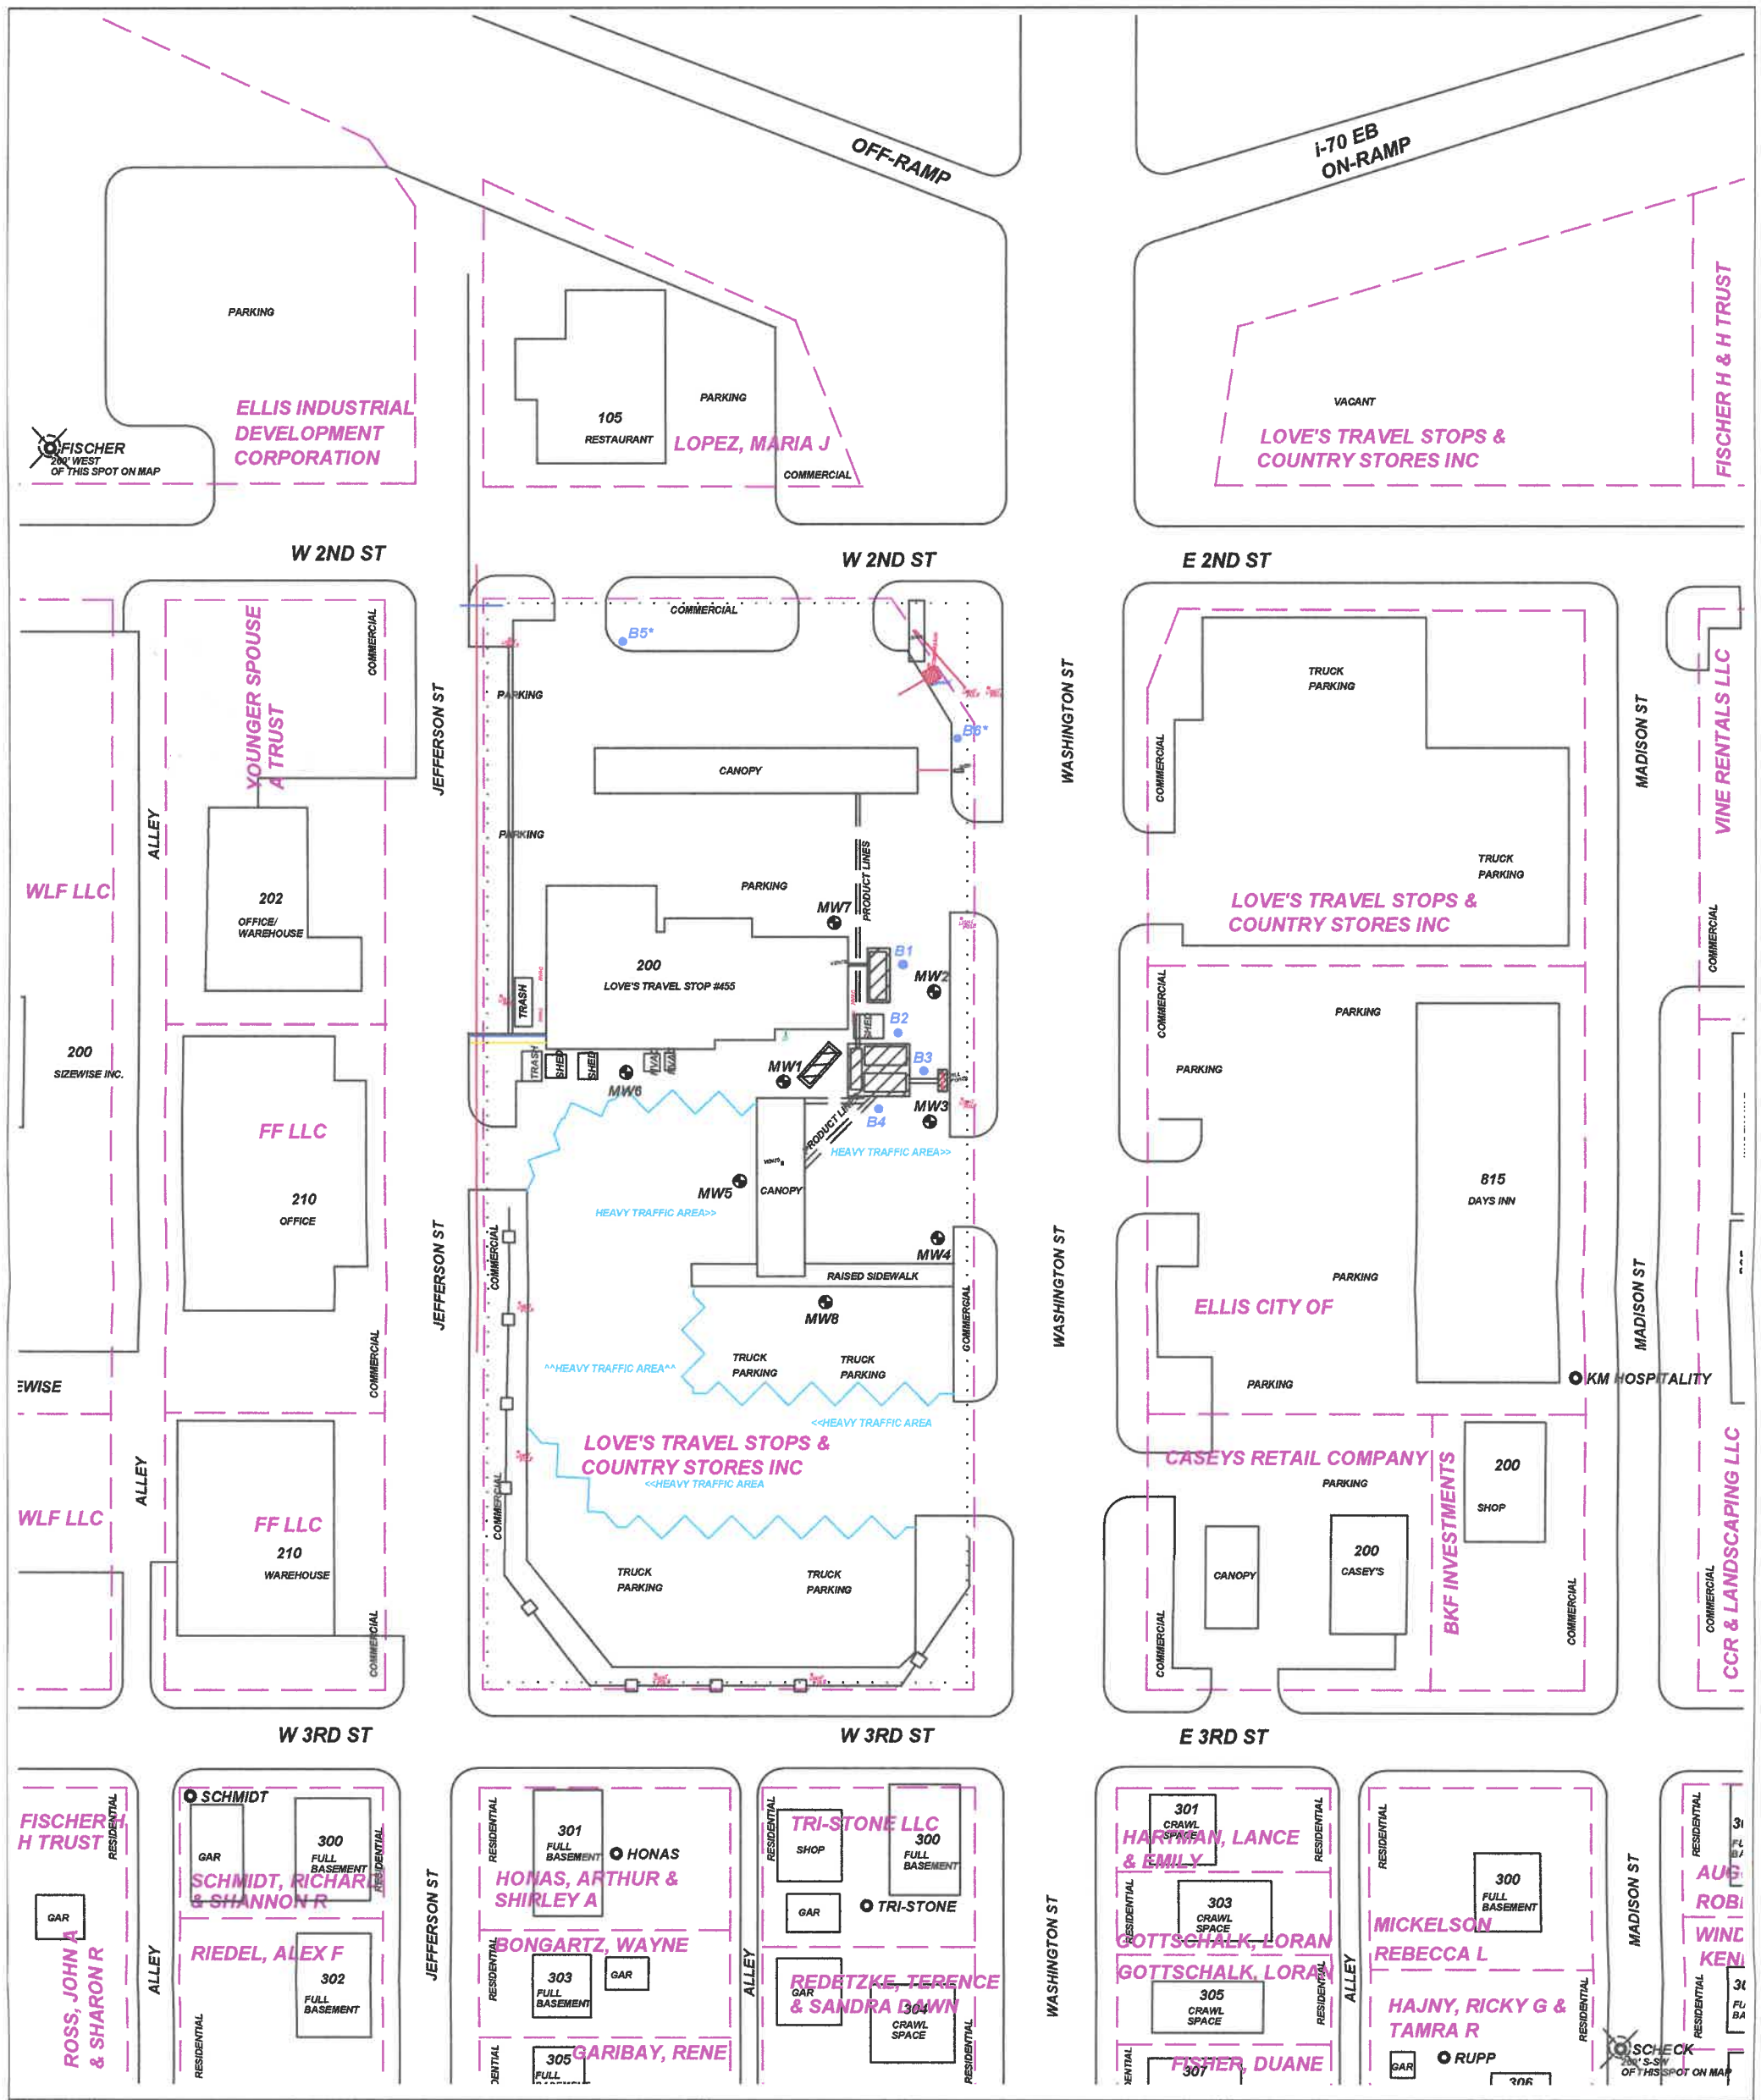

**PROJECT:** LOVE'S TRAVEL STOP #455  
**ADDRESS:** 200 WASHINGTON STREET  
**LOCATION:** ELLIS, KS  
**DRAWN BY:** C. ROE      **DATE:** 1/12/21  
**REVISED BY:** C. ROE      **DATE:** 4/2/21  
**AEI JOB #:** TF531      **KDHE JOB #:** U6-026-15219  
**SCALE:** 1" = 100'  
 0      50      100

**TITLE:** FIGURE 2.2  
 AREA BASE MAP  
 500' RADIUS  
**ASSOCIATED ENVIRONMENTAL INC.**

- LEGEND:**
- = 1-20,000 G UNLEADED, 1-8,000 G DEF, 2-20,000 G DIESEL, PRODUCT LINES, VENT LINES, & FILL PORT
  - = MONITORING WELL
  - = DOMESTIC WELL (OWNER NAME)
  - = SOIL BORING
  - = SUBJECT PROPERTY
  - = PARCEL BOUNDARY
  - = OVERHEAD ELECTRIC (10-25')
  - = BURIED ELECTRIC (2-5')
  - = BURIED WATER (3-6')
  - = BURIED GAS (2-4')
  - = BURIED SEWER (2-12')
  - = BURIED CABLE (2-5')

**NOTES:** Owner name/well id for domestic wells is the last name listed on the WWC5 form, but may not represent current property owners last name at each location.  
 \* = Indicates boring for unsaturated and saturated zone hydrologic data.