

**WATER WELL RECORD Form WWC-5**

Division of Water Resources App. No.

Well ID MW4

Original Record  Correction  Change in Well Use

<b>1 LOCATION OF WATER WELL:</b> County: ELLIS	Fraction NE ¼ SW ¼ NE ¼ SE ¼	Section Number 5	Township Number T 13 S	Range Number R 20 <input type="checkbox"/> E <input checked="" type="checkbox"/> W
---	---------------------------------	---------------------	---------------------------	---

<b>2 WELL OWNER:</b> Last Name: <b>Haney</b> First: <b>Gerald</b> Business: <b>Love's Travel Shops</b> Address: <b>10601 N. Pennsylvania</b> Address: City: <b>Oklahoma City</b> State: <b>OK</b> ZIP: <b>73120</b>	Street or Rural Address where well is located (if unknown, distance and direction from nearest town or intersection): If at owner's address, check here: <input type="checkbox"/> <b>200 Washington St.</b> <b>Ellis, KS 67637</b>
---	--

**3 LOCATE WELL WITH "X" IN SECTION BOX:**  
N

NW	NE
SW	SE

S

1 mile

**4 DEPTH OF COMPLETED WELL:** 50 ft.

Depth(s) Groundwater Encountered: 1) 42 ft.  
 2) ..... ft. 3) ..... ft., or 4)  Dry Well

WELL'S STATIC WATER LEVEL: 41.76 ft.  
 below land surface, measured on (mo-day-yr) 3/24/21  
 above land surface, measured on (mo-day-yr) .....

Pump test data: Well water was ..... ft.  
 after ..... hours pumping ..... gpm  
 Well water was ..... ft.  
 after ..... hours pumping ..... gpm

Estimated Yield: ..... gpm  
 Bore Hole Diameter: 8.5 in. to 50 ft. and  
 ..... in. to ..... ft.

**5 Latitude:** 38.94726 (decimal degrees)  
**Longitude:** 99.56042 (decimal degrees)  
 Horizontal Datum:  WGS 84  NAD 83  NAD 27  
 Source for Latitude/Longitude:  
 GPS (unit make/model: .....)  
 (WAAS enabled?  Yes  No)  
 Land Survey  Topographic Map  
 Online Mapper: .....

**6 Elevation:** 2136.06 ft.  Ground Level  TOC  
 Source:  Land Survey  GPS  Topographic Map  
 Other .....

**7 WELL WATER TO BE USED AS:**

1. Domestic: <input type="checkbox"/> Household <input type="checkbox"/> Lawn & Garden <input type="checkbox"/> Livestock 2. <input type="checkbox"/> Irrigation 3. <input type="checkbox"/> Feedlot 4. <input type="checkbox"/> Industrial	5. <input type="checkbox"/> Public Water Supply: well ID .....	10. <input type="checkbox"/> Oil Field Water Supply: lease .....
6. <input type="checkbox"/> Dewatering: how many wells? .....	7. <input type="checkbox"/> Aquifer Recharge: well ID .....	11. Test Hole: well ID .....
8. <input checked="" type="checkbox"/> Monitoring: well ID <b>MW3</b>	9. Environmental Remediation: well ID .....	12. Geothermal: how many bores? .....
<input type="checkbox"/> Air Sparge <input type="checkbox"/> Soil Vapor Extraction <input type="checkbox"/> Recovery <input type="checkbox"/> Injection		a) Closed Loop <input type="checkbox"/> Horizontal <input type="checkbox"/> Vertical b) Open Loop <input type="checkbox"/> Surface Discharge <input type="checkbox"/> Inj. of Water 13. <input type="checkbox"/> Other (specify): .....

Was a chemical/bacteriological sample submitted to KDHE?  Yes  No If yes, date sample was submitted: .....

Water well disinfected?  Yes  No

**8 TYPE OF CASING USED:**  Steel  PVC  Other .....

Casing diameter 2 in. to 50 ft., Diameter ..... in. to ..... ft., Diameter ..... in. to ..... ft.  
 Casing height above land surface ..... in. Weight ..... lbs./ft. Wall thickness or gauge No. **Sch. 40**

CASING JOINTS:  Glued  Clamped  Welded  Threaded

TYPE OF SCREEN OR PERFORATION MATERIAL:  
 Steel  Stainless Steel  Fiberglass  PVC  Other (Specify) .....

SCREEN OR PERFORATION OPENINGS ARE:  
 Continuous Slot  Mill Slot  Gauze Wrapped  Torch Cut  Drilled Holes  Other (Specify) .....

SCREEN-PERFORATED INTERVALS: From 35 ft. to 50 ft., From ..... ft. to ..... ft., From ..... ft. to ..... ft.  
 GRAVEL PACK INTERVALS: From 33 ft. to 35 ft., From ..... ft. to ..... ft., From ..... ft. to ..... ft.

**9 GROUT MATERIAL:**  Neat cement  Cement grout  Bentonite  Other **Concrete Surface Completion 0 - 1**

Grout Intervals: From 1 ft. to 33 ft., From ..... ft. to ..... ft., From ..... ft. to ..... ft.


Nearest source of possible contamination:  
 Septic Tank  Lateral Lines  Pit Privy  Livestock Pens  Insecticide Storage  
 Sewer Lines  Cess Pool  Sewage Lagoon  Fuel Storage  Abandoned Water Well  
 Watertight Sewer Lines  Seepage Pit  Feedyard  Fertilizer Storage  Oil Well/Gas Well  
 Other (Specify) .....

Direction from well? **South** Distance from well? **120** ft.


10 FROM	TO	LITHOLOGIC LOG	FROM	TO	LITHO. LOG (cont.) or PLUGGING INTERVALS
0	0.5	Concrete (8")			
1	32	Silty Clay (CL), brown			
32	34	Sandy Clay (SC), brown			
34	50	Silty Clay (CL), brown			

**Notes:** KDHE Storage Tanks (LUST) LSA Addendum Project  
 Love's Travel Stop #455, U6-026-15219, Ellis

**11 CONTRACTOR'S OR LANDOWNER'S CERTIFICATION:** This water well was  constructed,  reconstructed, or  plugged under my jurisdiction and was completed on (mo-day-year) **3/16/21** and this record is true to the best of my knowledge and belief. Kansas Water Well Contractor's License No. **585**. This Water Well Record was completed on (mo-day-year) **4/17/21** under the business name of **Associated Environmental, Inc.** Signature *[Signature]*

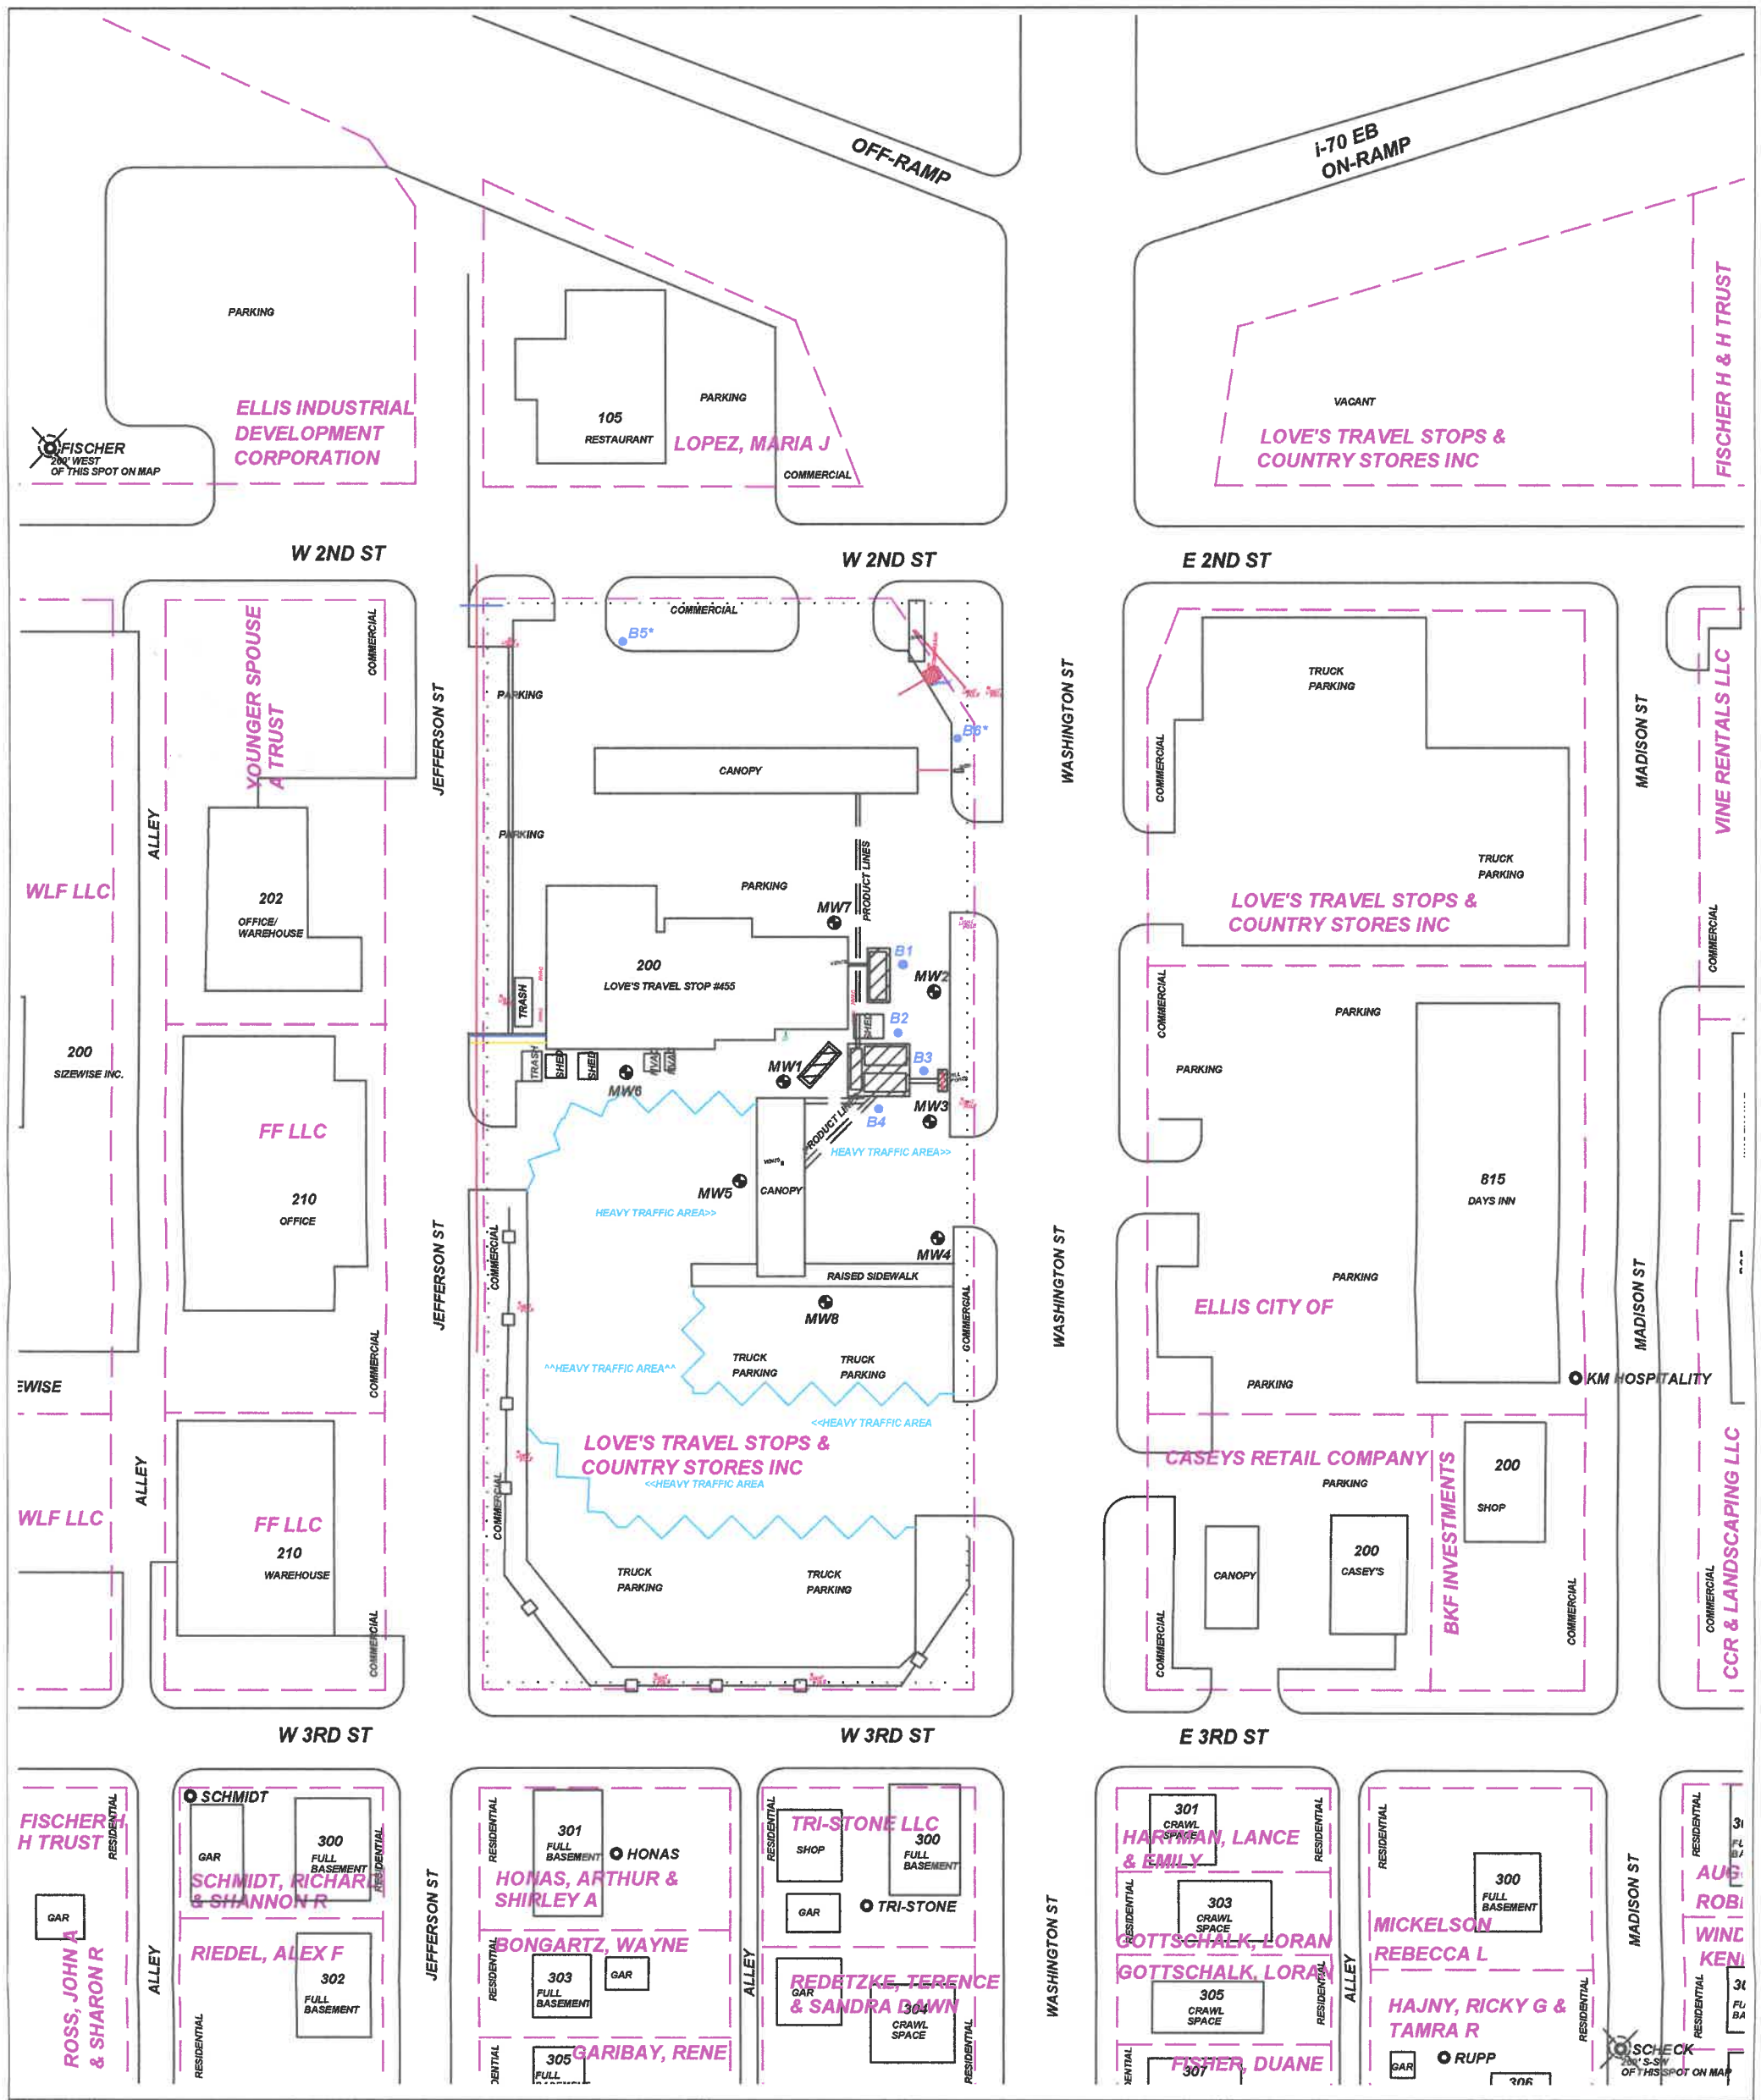

**PROJECT:** LOVE'S TRAVEL STOP #455  
**ADDRESS:** 200 WASHINGTON STREET  
**LOCATION:** ELLIS, KS  
**DRAWN BY:** C. ROE **DATE:** 1/12/21  
**REVISED BY:** C. ROE **DATE:** 4/2/21  
**AEI JOB #:** TF531 **KDHE JOB #:** U6-026-15219  
**SCALE:** 1" = 100'  
 0 50 100

**TITLE:** FIGURE 2.2  
 AREA BASE MAP  
 500' RADIUS  

**ASSOCIATED ENVIRONMENTAL INC.**

**NOTES:** Owner name/well id for domestic wells is the last name listed on the WWC5 form, but may not represent current property owners last name at each location.  
 \*= Indicates boring for unsaturated and saturated zone hydrologic data.

- LEGEND:**
- = 1-20,000 G UNLEADED, 1-8,000 G DEF, 2-20,000 G DIESEL, PRODUCT LINES, VENT LINES, & FILL PORT
  - = MONITORING WELL
  - = DOMESTIC WELL (OWNER NAME)
  - = SOIL BORING
  - = SUBJECT PROPERTY
  - = PARCEL BOUNDARY
  - = OVERHEAD ELECTRIC (10-25')
  - = BURIED ELECTRIC (2-5')
  - = BURIED WATER (3-6')
  - = BURIED GAS (2-4')
  - = BURIED SEWER (2-12')
  - = BURIED CABLE (2-5')