

WATER WELL PLUGGING RECORD Form WWC-5P KSA 82a-1212 ID NO.


MW7

1 LOCATION OF WATER WELL: County: ELLIS	Fraction NE ¼ SW¼ NE ¼ SE ¼	Section Number 5	Township Number T 13 S	Range Number 20 <input type="checkbox"/> E <input checked="" type="checkbox"/> W
---	--------------------------------	---------------------	---------------------------	---

Street/Rural Address of Well Location; if unknown, distance & direction from nearest town or intersection: If at owner's address, check here 200 WASHINGTON ST. ELLIS, KS 67637

Global Positioning Systems (GPS) information:
 Latitude: 38.94779 (in decimal degrees)
 Longitude: 99.56066 (in decimal degrees)
 Elevation: 2135.73
 Horizontal Datum: WGS84, NAD83, NAD27
 Collection Method:
 GPS unit (Make/Model: _____)
 Digital Map/Photo, Topographic Map, Land Survey
 Est. Accuracy: < 3 m, 3-5 m, 5-15 m, > 15 m

2 WATER WELL OWNER: GERALD HANEY
 RR#, St. Address, Box #: 10601 N. PENNSYLVANIA
 City, State ZIP Code: OKLAHOMA CITY, OK 73120

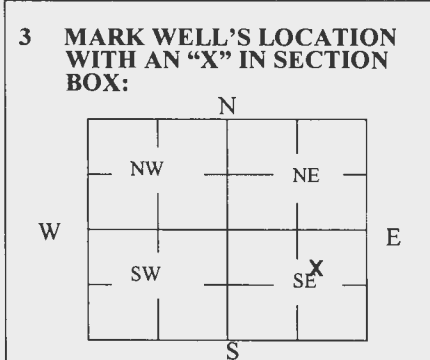

4 DEPTH OF WELL 45.03 ft.
 WELL'S STATIC WATER LEVEL 42.93 ft
 WELL WAS USED AS:
 Domestic Public Water Supply Dewatering
 Irrigation Oil Field Water Supply Monitoring
 Feedlot Domestic (Lawn & Garden) Injection Well
 Industrial Air Conditioning Other _____
 Was a chemical/bacteriological sample submitted to Department? Yes No

5 TYPE OF BLANK CASING USED:

Steel RMP (SR) Wrought Fiberglass Other (Specify below)
 PVC ABS Asbestos-Cement Concrete Tile

Blank casing diameter _____ in. Was casing pulled? Yes No If yes, how much 3'
 Casing height above or below land surface 36 in.


6 GROUT PLUG MATERIAL: Neat cement Cement grout Bentonite Other CONCRETE 0-0.5

Grout Plug Intervals: From 0.5 ft. to 45.03 ft., From _____ ft. to _____ ft., From _____ ft. to _____ ft.


What is the nearest source of possible contamination:
 Septic tank Seepage pit Fuel storage Other (specify below)
 Sewer lines Pit privy Fertilizer storage
 Watertight sewer lines Sewage lagoon Insecticide storage
 Lateral lines Feedyard Abandoned water well Direction from well? _____
 Cess pool Livestock pens Oil well/Gas well How many feet? _____

FROM	TO	PLUGGING MATERIALS	FROM	TO	PLUGGING MATERIALS
0	0.5	CONCRETE			
0.5	45.03	BENTONITE			




7 CONTRACTOR'S OR LANDOWNER'S CERTIFICATION: This water well was plugged under my jurisdiction and was completed on (mo/day/year) 4/17/23 and this record is true to the best of my knowledge and belief. Kansas Water Well Contractor's License No. 585. This Water Well Record was completed on (mo/day/year) 5/1/23 under the business name of ASSOCIATED ENVIRONMENTAL INC. by (signature) _____

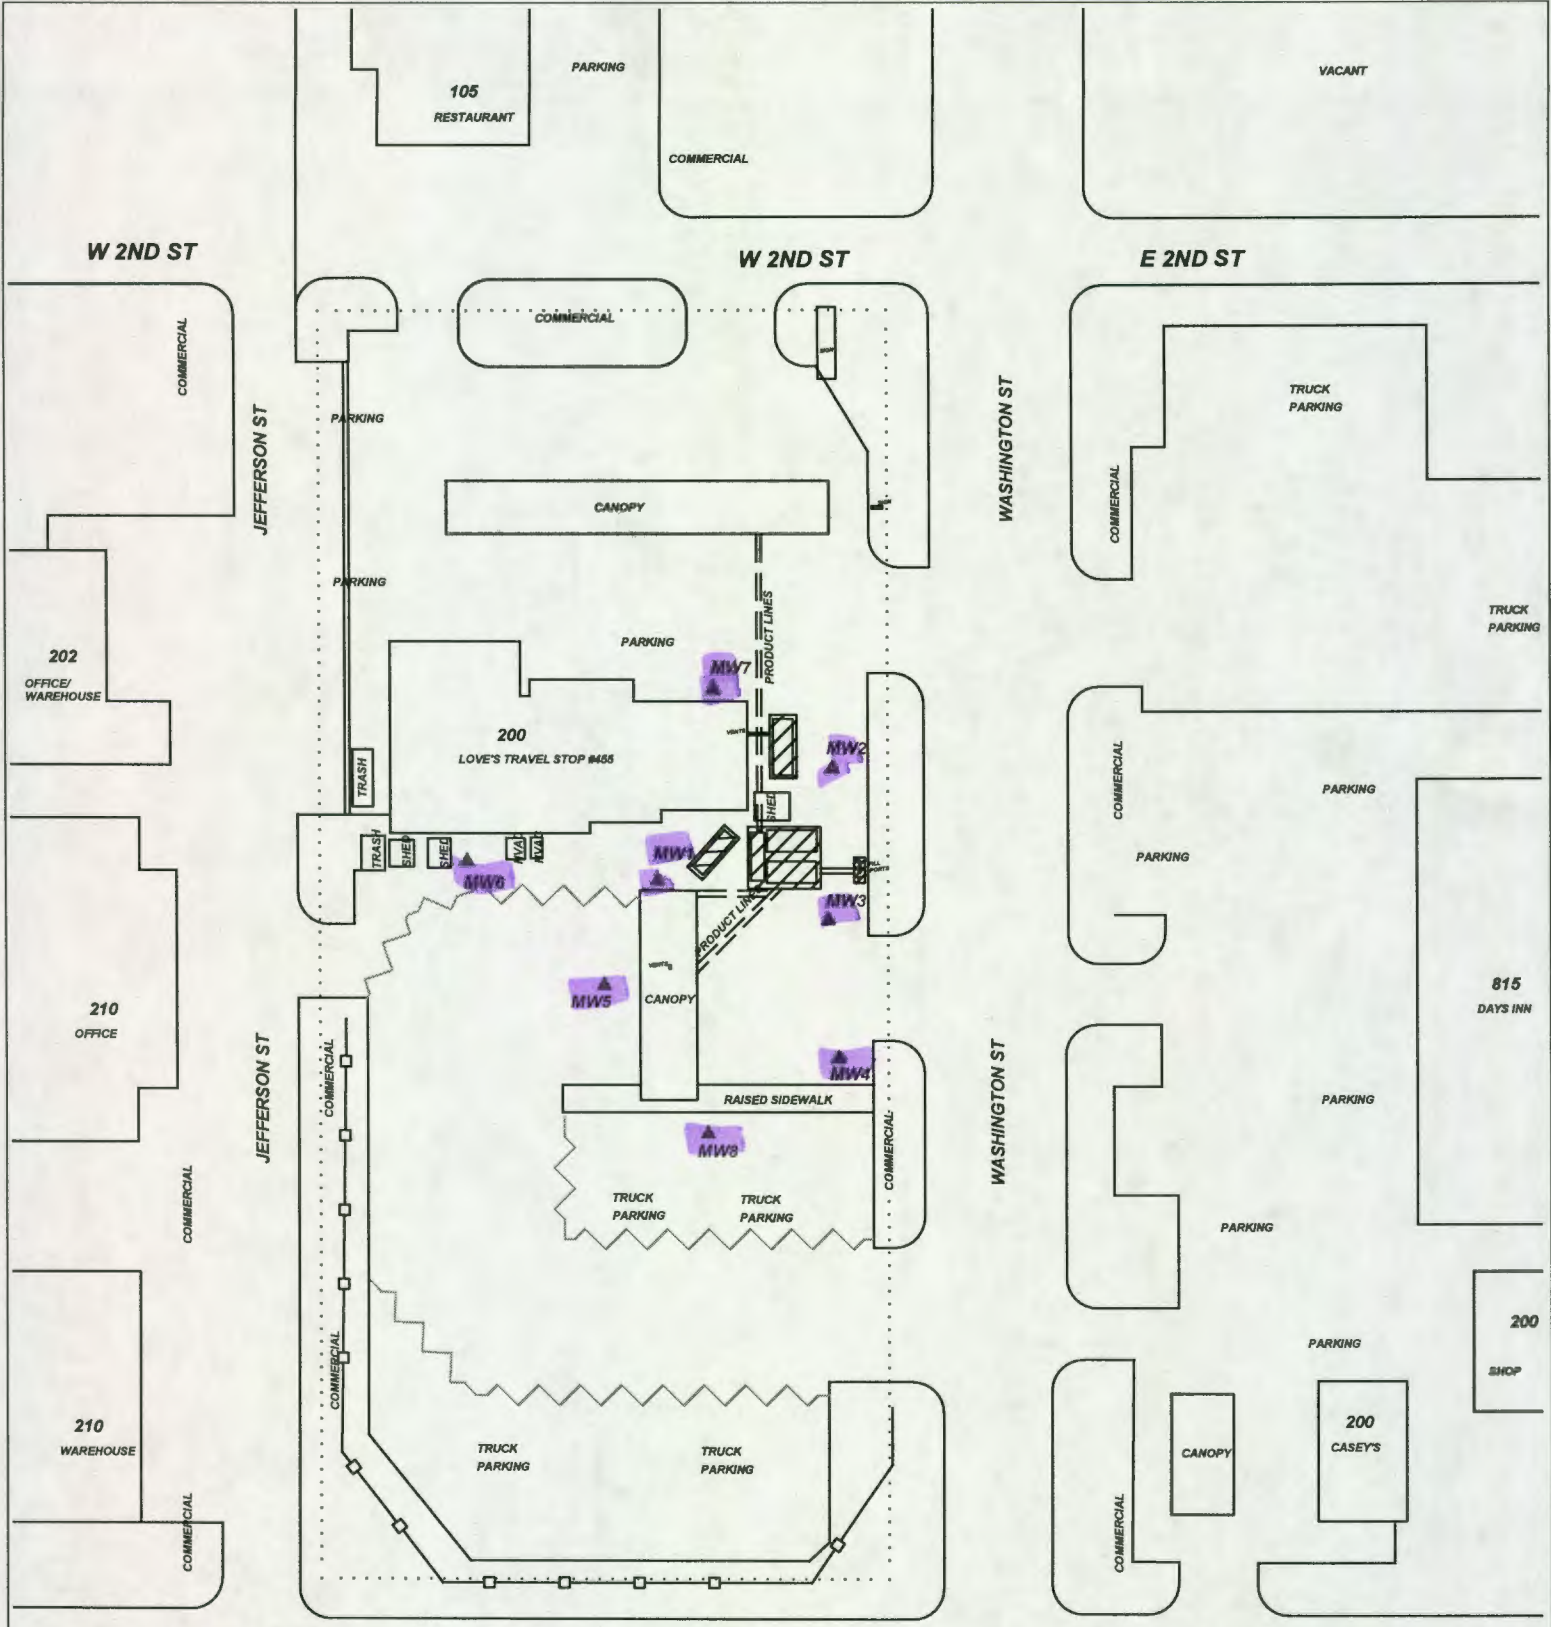


PROJECT: LOVE'S TRAVEL STOP #455
ADDRESS: 200 WASHINGTON STREET
LOCATION: ELLIS, KS
DRAWN BY: C. ROE **DATE:** 1/12/21
REVISED BY: B. STALNAKER **DATE:** 5/1/23
AEI JOB #: TF531 **KDHE JOB #:** U6-026-15219

TITLE:
 **ASSOCIATED ENVIRONMENTAL INC.**

LEGEND:

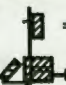 -  = 1-20,000 G UNLEADED, 1-8,000 G DEF, 2-20,000 G DIESEL, PRODUCT LINES, VENT LINES, & FILL PORT
-  = MONITORING WELL
-  = DOMESTIC WELL (OWNER NAME)
- = SUBJECT PROPERTY

SCALE: 1" = 100'


NOTES: Owner name/well id for domestic wells is the last name listed on the WWC5 form, but may not represent current property owners last name at each location.