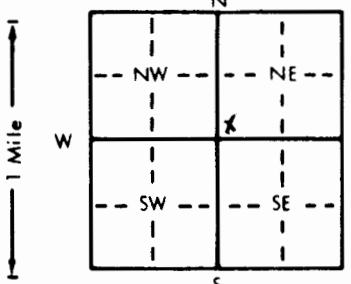


1 LOCATION OF WATER WELL: Fraction SW 1/4 SW 1/4 NE 1/4 Section Number 24 Township Number T 13 S Range Number R 20 EW
 County: Ellis

Distance and direction from nearest town or city street address of well if located within city?
1 mi South 3 1/2 mi East 1/2 mi South of Ellis Ks.

2 WATER WELL OWNER: Roma Boschowitzki
 RR#, St. Address, Box #: 652 Fairground Board of Agriculture, Division of Water Resources
 City, State, ZIP Code: Ellis Ks 67637 Application Number:

3 LOCATE WELL'S LOCATION WITH AN "X" IN SECTION BOX:


4 DEPTH OF COMPLETED WELL: 30 ft. ELEVATION:
 Depth(s) Groundwater Encountered 1. 5 ft. 2. ft. 3. ft.
 WELL'S STATIC WATER LEVEL 3 ft. below land surface measured on mo/day/yr 10/28/94
 Pump test data: Well water was 24 ft. after 1.5 hours pumping 20 gpm
 Est. Yield 20 gpm: Well water was ft. after hours pumping gpm
 Bore Hole Diameter: 1.0 in. to ft., and in. to ft.
 WELL WATER TO BE USED AS:
 1 Domestic 2 Irrigation 3 Feedlot 4 Industrial 5 Public water supply 6 Oil field water supply 7 Lawn and garden only 8 Air conditioning 9 Dewatering 10 Monitoring well 11 Injection well 12 Other (Specify below)
 Was a chemical/bacteriological sample submitted to Department? Yes No If yes, mo/day/yr sample was submitted Water Well Disinfected? Yes No

5 TYPE OF BLANK CASING USED:
 1 Steel 2 PVC 3 RMP (SR) 4 ABS 5 Wrought iron 6 Asbestos-Cement 7 Fiberglass 8 Concrete tile 9 Other (specify below) 10 Asbestos-cement 11 Other (specify) 12 None used (open hole)
 CASING JOINTS: Glued Clamped Welded Threaded
 Blank casing diameter in. to ft., Dia. in. to ft., Dia. in. to ft.
 Casing height above land surface 24 in., weight lbs./ft. Wall thickness or gauge No. SAR-26
 TYPE OF SCREEN OR PERFORATION MATERIAL:
 1 Steel 2 Brass 3 Stainless steel 4 Galvanized steel 5 Fiberglass 6 Concrete tile 7 PVC 8 RMP (SR) 9 ABS 10 Asbestos-cement 11 Other (specify) 12 None used (open hole)
 SCREEN OR PERFORATION OPENINGS ARE:
 1 Continuous slot 2 Louvered shutter 3 Mill slot 4 Key punched 5 Gauzed wrapped 6 Wire wrapped 7 Torch cut 8 Saw cut 9 Drilled holes 10 Other (specify) 11 None (open hole)
 SCREEN-PERFORATED INTERVALS: From 10 ft. to 30 ft. From ft. to ft. From ft. to ft.
 GRAVEL PACK INTERVALS: From 5 ft. to 30 ft. From ft. to ft. From ft. to ft.

6 GROUT MATERIAL: 1 Neat cement 2 Cement grout 3 Bentonite 4 Other
 Grout Intervals: From 2.5 ft. to 5 ft. From ft. to ft. From ft. to ft. From ft. to ft.
 What is the nearest source of possible contamination:
 1 Septic tank 2 Sewer lines 3 Watertight sewer lines 4 Lateral lines 5 Cess pool 6 Seepage pit 7 Pit privy 8 Sewage lagoon 9 Feedyard 10 Livestock pens 11 Fuel storage 12 Fertilizer storage 13 Insecticide storage 14 Abandoned water well 15 Oil well/Gas well 16 Other (specify below)
 Direction from well? East How many feet?

FROM	TO	LITHOLOGIC LOG	FROM	TO	PLUGGING INTERVALS
0	5	TOP SOIL			
5	25	med/coarse Red/Grey sand			
25	30	shale			

7 CONTRACTOR'S OR LANDOWNER'S CERTIFICATION: This water well was (1) constructed, (2) reconstructed, or (3) plugged under my jurisdiction and was completed on (mo/day/year) 10/28/94 and this record is true to the best of my knowledge and belief. Kansas Water Well Contractor's License No. 276 This Water Well Record was completed on (mo/day/yr) 10/28/94 under the business name of huen Water Well Drilling by (signature) John Huen

INSTRUCTIONS: Use typewriter or ball point pen. PLEASE PRESS FIRMLY and PRINT clearly. Please fill in blanks, underline or circle the correct answers. Send top three copies to Kansas Department of Health and Environment, Bureau of Water, Topeka, Kansas 66620-0001. Telephone: 913-296-5545. Send one to WATER WELL OWNER and retain one for your records.