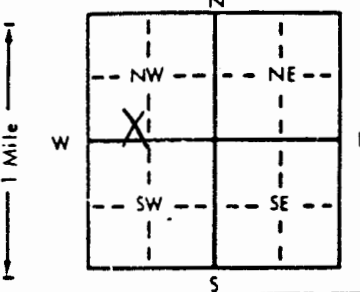


1 LOCATION OF WATER WELL: County: Ellis Fraction: SE 1/4 SW 1/4 NW 1/4 Section Number: 9 Township Number: T 13 S Range Number: R 20 E-W  
 Distance and direction from nearest town or city street address of well if located within city?  
1250 feet East-Southeast of Hwy 40 and Monroe

2 WATER WELL OWNER: Golden Belt Coop  
 RR#, St. Address, Box #: Monroe and Hwy 40 Board of Agriculture, Division of Water Resource  
 City, State, ZIP Code: Ellis, Kansas 67637 Application Number:

3 LOCATE WELL'S LOCATION WITH AN "X" IN SECTION BOX:  
  
 4 DEPTH OF COMPLETED WELL: 25 ft. ELEVATION: 2120  
 Depth(s) Groundwater Encountered 1. 20 ft. 2. \_\_\_\_\_ ft. 3. \_\_\_\_\_ ft.  
 WELL'S STATIC WATER LEVEL: 20.06 ft. TOC measured on mo/day/yr: 11-07-94  
 Pump test data: Well water was \_\_\_\_\_ ft. after \_\_\_\_\_ hours pumping \_\_\_\_\_ gpm  
 Est. Yield \_\_\_\_\_ gpm: Well water was \_\_\_\_\_ ft. after \_\_\_\_\_ hours pumping \_\_\_\_\_ gpm  
 Bore Hole Diameter: 8 in. to 25 ft., and \_\_\_\_\_ in. to \_\_\_\_\_ ft.  
 WELL WATER TO BE USED AS:  
 1 Domestic 3 Feedlot 5 Public water supply 8 Air conditioning 11 Injection well  
 2 Irrigation 4 Industrial 6 Oil field water supply 9 Dewatering 12 Other (Specify below)  
 7 Lawn and garden only 10 Monitoring well  
 Was a chemical/bacteriological sample submitted to Department? Yes \_\_\_\_\_ No X If yes, mo/day/yr sample was submitted \_\_\_\_\_  
 Water Well Disinfected? Yes \_\_\_\_\_ No X

5 TYPE OF BLANK CASING USED:  
 1 Steel 3 RMP (SR) 5 Wrought iron 8 Concrete tile CASING JOINTS: Glued \_\_\_\_\_ Clamped \_\_\_\_\_  
 2 PVC 4 ABS 6 Asbestos-Cement 9 Other (specify below) Welded \_\_\_\_\_  
 7 Fiberglass Threaded \_\_\_\_\_ X  
 Blank casing diameter: 2 in. to 15 ft., Dia \_\_\_\_\_ in. to \_\_\_\_\_ ft., Dia \_\_\_\_\_ in. to \_\_\_\_\_ ft.  
 Casing height above land surface: 0 in., weight \_\_\_\_\_ lbs./ft. Wall thickness or gauge No. sch. 40  
 TYPE OF SCREEN OR PERFORATION MATERIAL:  
 1 Steel 3 Stainless steel 5 Fiberglass 7 PVC 10 Asbestos-cement  
 2 Brass 4 Galvanized steel 6 Concrete tile 8 RMP (SR) 11 Other (specify) \_\_\_\_\_  
 9 ABS 12 None used (open hole)  
 SCREEN OR PERFORATION OPENINGS ARE:  
 1 Continuous slot 3 Mill slot 5 Gauzed wrapped 8 Saw cut 11 None (open hole)  
 2 Louvered shutter 4 Key punched 6 Wire wrapped 9 Drilled holes  
 7 Torch cut 10 Other (specify) \_\_\_\_\_  
 SCREEN-PERFORATED INTERVALS: From 15 ft. to 25 ft., From \_\_\_\_\_ ft. to \_\_\_\_\_ ft.  
 From \_\_\_\_\_ ft. to \_\_\_\_\_ ft., From \_\_\_\_\_ ft. to \_\_\_\_\_ ft.  
 GRAVEL PACK INTERVALS: From 13 ft. to 25 ft., From \_\_\_\_\_ ft. to \_\_\_\_\_ ft.  
 From \_\_\_\_\_ ft. to \_\_\_\_\_ ft., From \_\_\_\_\_ ft. to \_\_\_\_\_ ft.

6 GROUT MATERIAL: 1 Neat cement 2 Cement grout 3 Bentonite 4 Other \_\_\_\_\_  
 Grout intervals: From 0 ft. to 11 ft., From 11 ft. to 13 ft., From \_\_\_\_\_ ft. to \_\_\_\_\_ ft.  
 What is the nearest source of possible contamination:  
 1 Septic tank 4 Lateral lines 7 Pit privy 10 Livestock pens 14 Abandoned water well  
 2 Sewer lines 5 Cess pool 8 Sewage lagoon 11 Fuel storage 15 Oil well/Gas well  
 3 Watertight sewer lines 6 Seepage pit 9 Feedyard 12 Fertilizer storage 16 Other (specify below) Multiple  
 13 Insecticide storage  
 Direction from well? \_\_\_\_\_ How many feet? \_\_\_\_\_

| FROM | TO  | LITHOLOGIC LOG   | FROM | TO | PLUGGING INTERVALS |
|------|-----|--|------|----|--------------------|
| 0    | 1   | Cly, med brn, v slty, org rich, dry  |      |    |                    |
| 1    | 3   | Cly, lt brn, v slty, damp, sl plstc<br>tr of snd szd calic   |      |    |                    |
| 3    | 5.5 | Cly, a.a. but med brn  |      |    |                    |
| 5.5  | 9   | Cly, lt brn, v slty, sl plstc, damp  |      |    |                    |
| 9    | 15  | Silt, mod cly, v lt yell-brn, non-plst, damp   |      |    |                    |
| 15   | 18  | Snd, v f-f, sl med grns, rnd-subang well srted, v slty, damp                                       |      |    |                    |
| 18   | 25  | Snd, med-c grnd, sl grvl, mod snd-grvl szd calic, rnd-subang, frly well srted, lt brn w/ oran tint |      |    |                    |
|      |     |  |      |    | MW24 - Flushmount  |

7 CONTRACTOR'S OR LANDOWNER'S CERTIFICATION: This water well was (1) constructed, (2) reconstructed, or (3) plugged under my jurisdiction and was completed on (mo/day/year) 10-27-94 and this record is true to the best of my knowledge and belief. Kansas Water Well Contractor's License No. 527 This Water Well Record was completed on (mo/day/yr) 11-15-94 under the business name of GebCore Services, Inc. by (signature) Don Hill