


1 LOCATION OF WATER WELL: County: **Ehhis** Fraction: **SE 1/4 SE 1/4 SE 1/4** Section Number: **5** Township Number: **T 13 S** Range Number: **R 20 EW**

Distance and direction from nearest town or city street address of well if located within city?
508 DORRANCE St Ehhis Ks.

2 WATER WELL OWNER: **Kevin Fox**
 RR#, St. Address, Box #: **508 DORRANCE** Board of Agriculture, Division of Water Resources
 City, State, ZIP Code: **Ehhis Ks. 67637** Application Number:

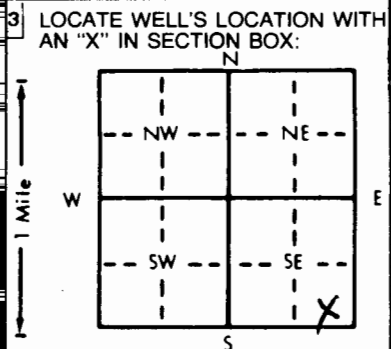

4 DEPTH OF COMPLETED WELL: **30'** ft. ELEVATION:
 Depth(s) Groundwater Encountered 1. **12** ft. 2. ft. 3. ft.
 WELL'S STATIC WATER LEVEL **11** ft. below land surface measured on mo/day/yr **5-11-95**
 Pump test data: Well water was **14** ft. after **1.5** hours pumping **20** gpm
 Est. Yield **20** gpm Well water was ft. after hours pumping gpm
 Bore Hole Diameter: **10** in. to ft., and in. to ft.
 WELL WATER TO BE USED AS: 5 Public water supply 8 Air conditioning 11 Injection well
 1 Domestic 3 Feedlot 6 Oil field water supply 9 Dewatering 12 Other (Specify below)
 2 Irrigation 4 Industrial **7** Lawn and garden only 10 Monitoring well
 Was a chemical/bacteriological sample submitted to Department? Yes No If yes, mo/day/yr sample was submitted
 Water Well Disinfected? **Yes** No

5 TYPE OF BLANK CASING USED:
 1 Steel 3 RMP (SR) 5 Wrought iron 8 Concrete tile CASING JOINTS: **Glued** Clamped
2 PVC 4 ABS 6 Asbestos-Cement 9 Other (specify below) Welded
 7 Fiberglass Threaded
 Blank casing diameter **5** in. to ft., Dia in. to ft., Dia in. to ft.
 Casing height above land surface: **20** in., weight lbs./ft. Wall thickness or gauge No. **SDR-26**

TYPE OF SCREEN OR PERFORATION MATERIAL:
 1 Steel 3 Stainless steel 5 Fiberglass **7 PVC** 10 Asbestos-cement
 2 Brass 4 Galvanized steel 6 Concrete tile 8 RMP (SR) 11 Other (specify)
 12 None used (open hole)

SCREEN OR PERFORATION OPENINGS ARE:
 1 Continuous slot 3 Mill slot 5 Gauzed wrapped 8 Saw cut 11 None (open hole)
 2 Louvered shutter 4 Key punched 6 Wire wrapped 9 Drilled holes
 7 Torch cut 10 Other (specify)

SCREEN-PERFORATED INTERVALS: From **10** ft. to **30** ft., From ft. to ft.
 GRAVEL PACK INTERVALS: From **8** ft. to **30** ft., From ft. to ft.

6 GROUT MATERIAL: 1 Neat cement 2 **Cement grout** 3 Bentonite 4 Other
 Grout Intervals: From **0** ft. to **8** ft., From ft. to ft., From ft. to ft.
 What is the nearest source of possible contamination:
 1 Septic tank 4 Lateral lines 7 Pit privy 10 Livestock pens 14 Abandoned water well
 2 Sewer lines 5 Cess pool 8 Sewage lagoon 11 Fuel storage 15 Oil well/Gas well
3 Watertight sewer lines 6 Seepage pit 9 Feedyard 12 Fertilizer storage 16 Other (specify below)
 13 Insecticide storage
 Direction from well? **North** How many feet? **25-35**

FROM	TO	LITHOLOGIC LOG	FROM	TO	PLUGGING INTERVALS
0	8	Top Soil			
8	27	med to fine Red & grey sand			
27	30	Shale			

7 CONTRACTOR'S OR LANDOWNER'S CERTIFICATION: This water well was **1** constructed, (2) reconstructed, or (3) plugged under my jurisdiction and was completed on (mo/day/year) **5-11-95** and this record is true to the best of my knowledge and belief. Kansas Water Well Contractor's License No. **276** This Water Well Record was completed on (mo/day/yr) **5-11-95** under the business name of **Lucas Water Well Drilling** by (signature) *John Lucas*

OFFICE USE ONLY
T
R
EW
SEC.
1/4
1/4
1/4