

WATER WELL PLUGGING RECORD Form WWC-5P


KSA 82a-1212

ID NO.

MW- 1

1 LOCATION OF WATER WELL: Fraction E E E Section Number 1 Township Number T 13 S Range Number 22 ☐ E ☒ W
 County: Trego 1/4 N 1/4 N 1/4 N 1/4
 Street/Rural Address of Well Location; if unknown, distance & direction from nearest town or intersection: If at owner's address, check here ☐ ~ 300' southwest of 350 Ave. and Emmeram Rd. Trego County
 Global Positioning Systems (GPS) information:
 Latitude: 38.97881 (in decimal degrees)
 Longitude: -99.707001 (in decimal degrees)
 Elevation:
 Horizontal Datum: ☒ WGS84, ☐ NAD83, ☐ NAD27
 Collection Method:

2 WATER WELL OWNER: Koch Pipeline Co.
 RR#, St. Address, Box #: 411 E. 37th St. North
 City, State ZIP Code: Wichita KS 67220
☒ GPS unit (Make/Model: Garmin etrek
☐ Digital Map/Photo, ☐ Topographic Map, ☐ Land Survey
 Est. Accuracy: ☐ < 3 m, ☒ 3-5 m, ☐ 5-15 m, ☐ > 15 m

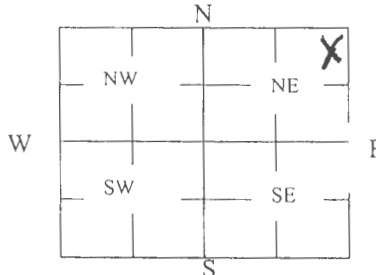3 MARK WELL'S LOCATION WITH AN "X" IN SECTION BOX:

 4 DEPTH OF WELL 20 ft.
 WELL'S STATIC WATER LEVEL 7.5 ft.
 WELL WAS USED AS:
☐ Domestic ☐ Public Water Supply ☐ Dewatering
☐ Irrigation ☐ Oil Field Water Supply ☒ Monitoring
☐ Feedlot ☐ Domestic (Lawn & Garden) ☐ Injection Well
☐ Industrial ☐ Air Conditioning ☐ Other _____
 Was a chemical/bacteriological sample submitted to Department? Yes ☐ No ☒

5 TYPE OF BLANK CASING USED:
☐ Steel ☐ RMP (SR) ☐ Wrought ☐ Fiberglass ☐ Other (Specify below)
☒ PVC ☐ ABS ☐ Asbestos-Cement ☐ Concrete Tile
 Blank casing diameter 4 in. Was casing pulled? Yes ☒ No ☐ If yes, how much all
 Casing height above or below land surface 36 in.

6 GROUT PLUG MATERIAL: ☐ Neat cement ☐ Cement grout ☒ Bentonite ☒ Other Top Soil
 Grout Plug Intervals: From 0 ft. to 3 ft., From 3 ft. to 20 ft., From - ft. to - ft.
 What is the nearest source of possible contamination:
☐ Septic tank ☐ Seepage pit ☐ Fuel storage ☒ Other (specify below)
☐ Sewer lines ☐ Pit privy ☐ Fertilizer storage oil pipeline
☐ Watertight sewer lines ☐ Sewage lagoon ☐ Insecticide storage
☐ Lateral lines ☐ Feedyard ☐ Abandoned water well Direction from well? _____
☐ Cess pool ☐ Livestock pens ☐ Oil well/Gas well How many feet? _____

FROM	TO	PLUGGING MATERIALS	FROM	TO	PLUGGING MATERIALS
0	3	Top Soil			
3	20	Bentonite			

7 CONTRACTOR'S OR LANDOWNER'S CERTIFICATION: This water well was plugged under my jurisdiction and was completed on (mo/day/year) 11/19/2018 and this record is true to the best of my knowledge and belief. Kansas Water Well Contractor's License No. 710. This Water Well Record was completed on (mo/day/year) 11/20/2018 under the business name of Below Ground Surface, Inc. by (signature) Craig R. Hew

Send one white copy to Kansas Department of Health & Environment, Geology Section, 1000 SW Jackson Street, Ste. 420, Topeka, KS 66612-1367. Send one copy to WATER WELL OWNER and retain one for your records.

Visit us at <http://www.kdheks.gov/waterwell/index.html> Telephone 785-296-5524.


17290 NE NE NE 1-13-22

U:\Koch\Kreling\GIS\Documents\Project_Map\Wsch_631225062_006_dreling_site_map.mxd Analyst: jeremy penton Date: 7/6/2018 10:18:56 AM



- LEGEND**
- ▲ Monitor Well on Current Sampling Schedule
 - ▽ Monitor Well Not on Current Sampling Schedule

RECEIVED
DEC 10 4 018
BUREAU OF WATER

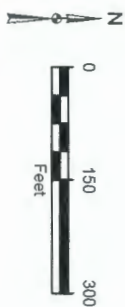

REFERENCE
Source: Esri, DeLorme, USGS, USGS, AEX, GeoEye, GeoEye, AeroMap, Airphoto, IGN, IGN, and the GIS User Community



2877 NORTH RIDGE ROAD, SUITE 102B
WICHITA, KANSAS 67205
(316) 220-8020

SITE MAP

CLIENT:
KOCH

LOCATION:
DREILING LEASE

FIGURE:
1