

**WATER WELL PLUGGING RECORD Form WWC-5P**

KSA 82a-1212

ID NO.

MW-10


**1 LOCATION OF WATER WELL:** Fraction E E E Section Number 1 Township Number T 13 S Range Number 22  E  W  
 County: Trego  $\frac{1}{4}$  N  $\frac{1}{4}$  N'  $\frac{1}{4}$  N'  $\frac{1}{4}$

Street/Rural Address of Well Location; if unknown, distance & direction from nearest town or intersection: If at owner's address, check here  ~1100 feet south of 350 Av. and Emmeram Rd. Trego County

**Global Positioning Systems (GPS) information:**  
 Latitude: 38.955001 (in decimal degrees)  
 Longitude: -99.706137 (in decimal degrees)  
 Elevation: \_\_\_\_\_  
 Horizontal Datum:  WGS84,  NAD83,  NAD27  
 Collection Method: \_\_\_\_\_

**2 WATER WELL OWNER:** Koch Pipeline Co.  
 RR#, St. Address, Box #: 411 E. 37th St. North  
 City, State ZIP Code: Wichita KS 67220

GPS unit (Make/Model: Garmin etrek)  
 Digital Map/Photo,  Topographic Map,  Land Survey  
 Est. Accuracy:  < 3 m,  3-5 m,  5-15 m,  > 15 m

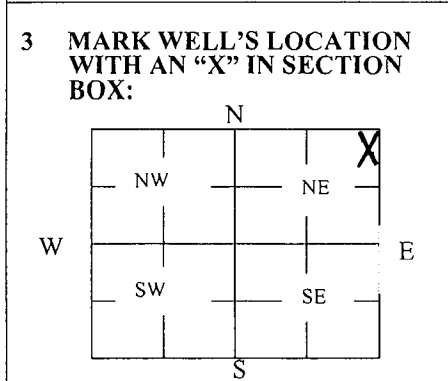

**4 DEPTH OF WELL** 15 ft.  
 WELL'S STATIC WATER LEVEL \_\_\_\_\_ ft.  
 WELL WAS USED AS:

Domestic  Public Water Supply  Dewatering  
 Irrigation  Oil Field Water Supply  Monitoring  
 Feedlot  Domestic (Lawn & Garden)  Injection Well  
 Industrial  Air Conditioning  Other \_\_\_\_\_

Was a chemical/bacteriological sample submitted to Department? Yes  No

**5 TYPE OF BLANK CASING USED:**

Steel  RMP (SR)  Wrought  Fiberglass  Other (Specify below)  
 PVC  ABS  Asbestos-Cement  Concrete Tile

Blank casing diameter 4 in. Was casing pulled? Yes  No  If yes, how much all  
 Casing height above or below land surface \_\_\_\_\_ in.

**6 GROUT PLUG MATERIAL:**  Neat cement  Cement grout  Bentonite  Other Top Soil

Grout Plug Intervals: From 0 ft. to 3 ft., From 3 ft. to 15 ft., From - ft. to - ft.

What is the nearest source of possible contamination:

Septic tank  Seepage pit  Fuel storage  Other (specify below)  
 Sewer lines  Pit privy  Fertilizer storage oil pipeline  
 Watertight sewer lines  Sewage lagoon  Insecticide storage  
 Lateral lines  Feedyard  Abandoned water well Direction from well? \_\_\_\_\_  
 Cess pool  Livestock pens  Oil well/Gas well How many feet? \_\_\_\_\_

FROM	TO	PLUGGING MATERIALS	FROM	TO	PLUGGING MATERIALS
0	3	Top Soil			
3	15	Bentonite			

**7 CONTRACTOR'S OR LANDOWNER'S CERTIFICATION:** This water well was plugged under my jurisdiction and was completed on (mo/day/year) 11/19/2018 and this record is true to the best of my knowledge and belief. Kansas Water Well Contractor's License No. 710. This Water Well Record was completed on (mo/day/year) 11/20/2018 under the business name of Below Ground Surface, Inc. by (signature) Craig R. [Signature]

Send one white copy to Kansas Department of Health & Environment, Geology Section, 1000 SW Jackson Street, Ste. 420, Topeka, KS 66612-1367. Send one copy to WATER WELL OWNER and retain one for your records.  
 Visit us at <http://www.kdheks.gov/waterwell/index.html> Telephone 785-296-5524.

1-13-22

NE NE NE

1 Rego



D:\GIS\Geographic\_Information\_Systems\Projects\Map\_Series\Map\_Series\Map\_Series.aprx / 1-13-22 10:19:44 AM

**LEGEND**

- ▲ Monitor Well on Current Sampling Schedule
- △ Monitor Well Not on Current Sampling Schedule

RECEIVED  
 FEB 04 2018  
 BUREAU OF WATER



REFERENCE  
 Source: Esri, Intel, USGS, USGS, AER, GeoEye, Geomapping, Aerogrid, IGN, IGP, and the GIS User Community



2872 NORTH RIDGE ROAD, SUITE 102B  
 WICHITA, KANSAS 67205  
 (316) 220-8020

**SITE MAP**

CLIENT: KOCH	
LOCATION: DREILING LEASE	FIGURE 1