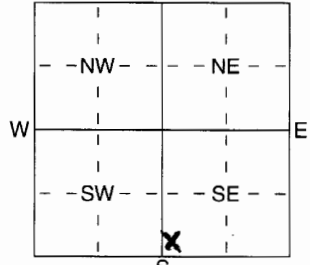


1 LOCATION OF WATER WELL:	Fraction	Section Number	Township Number	Range Number
County: TR TREGO	SW 1/4 SW 1/4 SE 1/4	2	T 13 S	R 23 E/W

Distance and direction from nearest town or city street address of well if located within city?
 5 miles South and 2 1/2 East of Wakeeney KS

2 WATER WELL OWNER: LANNY FABRIZIUS
 RR#, St. Address, Box # : ~~120 N 2nd~~ RR2 BOX 22A Board of Agriculture, Division of Water Resources
 City, State, ZIP Code : WAKEENEY KS 67672 Application Number:

3 LOCATE WELL'S LOCATION WITH AN "X" IN SECTION BOX:	4 DEPTH OF COMPLETED WELL 41 ft. ELEVATION:	5 WELL'S STATIC WATER LEVEL 21 ft. below land surface measured on mo/day/yr 8-3-05
	Depth(s) Groundwater Encountered 1 21 ft. 2 ft. 3 ft.	Pump test data: Well water was ft. after hours pumping gpm
	Est. Yield 12 gpm: Well water was ft. after hours pumping gpm	WELL WATER TO BE USED AS: 5 Public water supply 8 Air conditioning 11 Injection well
	<input checked="" type="checkbox"/> Domestic 3 Feedlot 6 Oil field water supply 9 Dewatering 12 Other (Specify below)	2 Irrigation 4 Industrial 7 Domestic (lawn & garden) 10 Monitoring well
	Was a chemical/bacteriological sample submitted to Department? Yes No <u>XX</u> ; If yes, mo/day/yr sample was submitted Water Well Disinfected? Yes No <u>XX</u>	

5 TYPE OF BLANK CASING USED:

1 Steel	3 RMP (SR)	5 Wrought iron	8 Concrete tile	CASING JOINTS: Glued <u>XX</u> Clamped
<u>XX</u> PVC	4 ABS	6 Asbestos-Cement	9 Other (specify below)	Welded
	5	7 Fiberglass		Threaded

Blank casing diameter in. to 2.6 ft., Dia in. to ft., Dia in. to ft.
 Casing height above land surface 1.8 in., weight 1.60 lbs./ft. Wall thickness or gauge No.

TYPE OF SCREEN OR PERFORATION MATERIAL:

1 Steel	3 Stainless Steel	5 Fiberglass	<u>XX</u> RVC	10 Asbestos-Cement
2 Brass	4 Galvanized Steel	6 Concrete tile	8 RMP (SR)	11 Other (Specify)
			9 ABS	12 None used (open hole)

SCREEN OR PERFORATION OPENINGS ARE:

1 Continuous slot	<u>3</u> Mit slot	5 Gauzed wrapped	8 Saw cut	11 None (open hole)
2 Louvered shutter	4 Key punched	6 Wire wrapped	9 Drilled holes	
		7 Torch cut	10 Other (specify)	ft.

SCREEN-PERFORATED INTERVALS: From 2.6 ft. to 4.1 ft., From ft. to ft.
 GRAVEL PACK INTERVALS: From 2.6 ft. to 4.1 ft., From ft. to ft.

6 GROUT MATERIAL: 1 Neat cement 2 Cement grout 3 Bentonite 4 Other

Grout Intervals: From 0 ft. to 2.6 ft., From ft. to ft., From ft. to ft.

What is the nearest source of possible contamination:

1 Septic tank	4 Lateral lines	7 Pit privy	10 Livestock pens	14 Abandoned water well
2 Sewer lines	5 Cess pool	8 Sewage lagoon	11 Fuel storage	15 Oil well/Gas well
3 Watertight sewer lines	6 Seepage pit	9 Feedyard	12 Fertilizer storage	16 Other (specify below)
			13 Insecticide storage	

Direction from well? How many feet?

FROM	TO	LITHOLOGIC LOG	FROM	TO	PLUGGING INTERVALS
0	10	SURFACE CLAY			
10	20	HARD YELLOW CLAY			
20	25	FINE SAND			
25	32	MED SAND			
32	42	BLUE SHALE			

7 CONTRACTOR'S OR LANDOWNER'S CERTIFICATION: This water well was XX constructed, (2) reconstructed, or (3) plugged under my jurisdiction and was completed on (mo/day/year) 8-3-05 and this record is true to the best of my knowledge and belief. Kansas Water Well Contractor's Licence No 444 This Water Well Record was completed on (mo/day/yr) 8-3-05 under the business name of ANDY ANDERSON DRILING by (signature) *Andy Anderson*

INSTRUCTIONS: Use typewriter or ball point pen. PLEASE PRESS FIRMLY and PRINT clearly. Please fill in blanks, underline or circle the correct answers. Send top three copies to Kansas Department of Health and Environment, Bureau of Water, Geology Section, 1000 SW Jackson St., Suite 420, Topeka, Kansas 66612-1367. Telephone 785-296-5522. Send one to WATER WELL OWNER and retain one for your records. Fee of \$5.00 for each constructed well.