


| | | | | | |
|---|-------------------------|-----------------------------|----------------|-----------------|--------------|
| 1 | LOCATION OF WATER WELL: | Fraction | Section Number | Township Number | Range Number |
| | County: <u>Trego</u> | <u>SE 1/4 SE 1/4 SW 1/4</u> | <u>29</u> | <u>13 S</u> | <u>23 W</u> |

Distance and direction from nearest town or city street address of well if located within city?
Hwy 283 & Trego Center go W - 1/2 mile Then North into Pasture

| | |
|---|---|
| 2 | WATER WELL OWNER: <u>Roberta Newcomer</u> |
| | RR#, St. Address, Box #: <u>604 8th</u> Board of Agriculture, Division of Water Resources |
| | City, State, ZIP Code: <u>Wakeeney KS 67672</u> Application Number: |

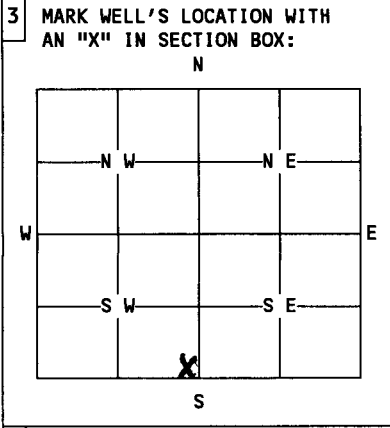

4 DEPTH OF WELL.....40.....ft.

WELL'S STATIC WATER LEVEL 35.....ft.

WELL WAS USED AS:

| | | |
|-------------------|--------------------------|--------------------|
| <u>1</u> Domestic | 5 Public Water Supply | 9 Dewatering |
| 2 Irrigation | 6 Oil Field Water Supply | 10 Monitoring Well |
| 3 Feedlot | 7 Lawn and Garden Only | 11 Injection Well |
| 4 Industrial | 8 Air Conditioning | 12 Other..... |

Was a chemical/bacteriological sample submitted to Department? Yes....No X
 If yes, mo/day/yr sample was submitted.....

Water Well Disinfected: Yes X.. No.....

5 TYPE OF BLANK CASING USED:

| | | | | |
|---------|------------|-------------------|-----------------|-------------------------|
| 1 Steel | 3 RMP (SR) | 5 Wrought | 7 Fiberglass | 9 Other (specify below) |
| 2 PVC | 4 ABS | 6 Asbestos-Cement | 8 Concrete Tile | <u>Limestone Rock</u> |

Blank casing diameter...4.8.....in. Was casing pulled? Yes..... No X. If yes, how much.....
 Casing height above or below land surface...5.0 Below.....

6 GROUT PLUG MATERIAL: 1 Neat cement 2 Cement grout 3 Bentonite 4 Other.....

Grout Plug Intervals: From 60" to 80", From.....ft. toft., From..... to.....ft.

What is the nearest source of possible contamination:

| | | | |
|--------------------------|-------------------|-------------------------|--------------------------|
| 1 Septic tank | 6 Seepage pit | 11 Fuel storage | 16 Other (specify below) |
| 2 Sewer lines | 7 Pit privy | 12 Fertilizer storage | <u>...pasture...</u> |
| 3 Watertight sewer lines | 8 Sewage lagoon | 13 Insecticide storage | |
| 4 Lateral lines | 9 Feedyard | 14 Abandoned water well | |
| 5 Cess Pool | 10 Livestock pens | 15 Oil well/Gas well | |

Direction from well? ...Around..... How many feet? ...15'.....

| FROM | TO | PLUGGING MATERIALS |
|------------|------------|----------------------------|
| <u>40'</u> | <u>34'</u> | <u>Clean Sand</u> |
| <u>34'</u> | <u>7'</u> | <u>Clean Clay sub soil</u> |
| <u>7'</u> | <u>5'</u> | <u>Bentonite Hole Plug</u> |
| <u>5'</u> | <u>0'</u> | <u>Fill in Top soil</u> |
| | | |
| | | |

7 CONTRACTOR'S OR LANDOWNER'S CERTIFICATION: This water well was plugged under my jurisdiction and was completed on (mo/day/year) ...8-28-96... and this record is true to the best of my knowledge and belief. Kansas Water Well Contractor's License No. This Water Well Record was completed on (mo/day/year) under the business name of Bolles Ditch, Inc by (signature) Eddie Bolles

INSTRUCTIONS: Use typewriter or ball point pen. Please press firmly and print clearly. Please fill in blanks, underline or circle the correct answers. Send top three copies to Kansas Department of Health and Environment, Bureau of Water, Topeka, Kansas 66620-0001. Telephone: 913/296-3565. Send one to Water Well Owner and retain one for your records.