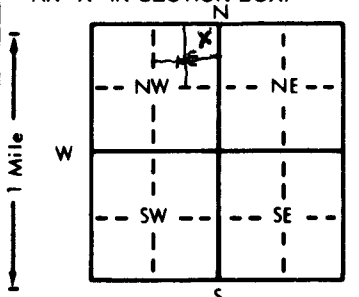


1 LOCATION OF WATER WELL: County: Trego Fraction: NE 1/4 NE 1/4 NW 1/4 Section Number: W 1/2 18 Township Number: T 13 S Range Number: R 24 E/W

Distance and direction from nearest town or city street address of well if located within city?
7W + 6 1/2 S of 1-70 + 1/2 W

2 WATER WELL OWNER: Louis Felder
 RR#, St. Address, Box #: R.R. 2 Box 116 Wa Keeney, Kansas 67672 Board of Agriculture, Division of Water Resources
 City, State, ZIP Code: R.R. 2 Box 116 Wa Keeney, Kansas 67672 Application Number:

3 LOCATE WELL'S LOCATION WITH AN "X" IN SECTION BOX:


4 DEPTH OF COMPLETED WELL: 64 ft. ELEVATION:
 Depth(s) Groundwater Encountered: 59 ft. 2. ft. 3. ft.
 WELL'S STATIC WATER LEVEL: 59 ft. below land surface measured on mo/day/yr
 Pump test data: Well water was ft. after hours pumping gpm
 Est. Yield gpm: Well water was ft. after hours pumping gpm
 Bore Hole Diameter: in. to ft., and in. to ft.
 WELL WATER TO BE USED AS: 5 Public water supply 8 Air conditioning 11 Injection well
 1 Domestic 3 Feedlot 6 Oil field water supply 9 Dewatering 12 Other (Specify below)
 2 Irrigation 4 Industrial 7 Lawn and garden only 10 Monitoring well
 Was a chemical/bacteriological sample submitted to Department? Yes.....No.....; If yes, mo/day/yr sample was submitted
 Water Well Disinfected? Yes No

5 TYPE OF BLANK CASING USED: 5 Wrought iron 8 Concrete tile CASING JOINTS: Glued Clamped
 1 Steel 3 RMP (SR) 6 Asbestos-Cement 9 Other (specify below) Welded
 2 PVC 4 ABS 7 Fiberglass Threaded: ?
 Blank casing diameter: 5 in. to 64 ft., Dia in. to ft., Dia in. to ft.
 Casing height below above land surface: 36 in., weight lbs./ft. Wall thickness or gauge No.
 TYPE OF SCREEN OR PERFORATION MATERIAL: 7 PVC 10 Asbestos-cement
 1 Steel 3 Stainless steel 5 Fiberglass 8 RMP (SR) 11 Other (specify) N/A
 2 Brass 4 Galvanized steel 6 Concrete tile 9 ABS 12 None used (open hole)
 SCREEN OR PERFORATION OPENINGS ARE: 5 Gauzed wrapped 8 Saw cut 11 None (open hole)
 1 Continuous slot 3 Mill slot 6 Wire wrapped 9 Drilled holes
 2 Louvered shutter 4 Key punched 7 Torch cut 10 Other (specify) N/A
 SCREEN-PERFORATED INTERVALS: From N/A ft. to NA ft., From ft. to ft.
 From ft. to ft., From ft. to ft.
 GRAVEL PACK INTERVALS: From N/A ft. to ft., From ft. to ft.
 From ft. to ft., From ft. to ft.

6 GROUT MATERIAL: 1 Neat cement 2 Cement grout 3 Bentonite 4 Other
 Grout Intervals: From 9 ft. to 4 ft., From ft. to ft., From ft. to ft.
 What is the nearest source of possible contamination: 10 Livestock pens 14 Abandoned water well
 1 Septic tank 4 Lateral lines 7 Pit privy 11 Fuel storage 15 Oil well/Gas well
 2 Sewer lines 5 Cess pool 8 Sewage lagoon 12 Fertilizer storage 16 Other (specify below)
 3 Watertight sewer lines 6 Seepage pit 9 Feedyard 13 Insecticide storage Abandon Feed lot
 Direction from well? How many feet?

FROM	TO	LITHOLOGIC LOG	FROM	TO	PLUGGING INTERVALS
			0	3	Pit
			3	4	Conc.
			4	9	Bentonite
			9	52	Clay soil
			52	64	Sand

7 CONTRACTOR'S OR LANDOWNER'S CERTIFICATION: This water well was (1) constructed, (2) reconstructed, or (3) plugged under my jurisdiction and was completed on (mo/day/year) 10-15-92 and this record is true to the best of my knowledge and belief. Kansas Water Well Contractor's License No. None This Water Well Record was completed on (mo/day/yr) 11-17-92 under the business name of None by (signature) Louis Felder

OFFICE USE ONLY T R EW SEC.