


1 LOCATION OF WATER WELL: County: **TR290** Fraction: **SW 1/4 NE 1/4 NE 1/4** Section Number: **28** Township Number: **T 13 S** Range Number: **R 24 E**

Distance and direction from nearest town or city street address of well if located within city?  
**8 South 3/4 West of Wakeeney KS 67672**

2 WATER WELL OWNER: **MELVIN FABRIZIUS**  
 RR#, St. Address, Box #: **325 North Nine**  
 City, State, ZIP Code: **Wakeeney KS 67672**  
 Board of Agriculture, Division of Water Resources  
 Application Number:

3 LOCATE WELL'S LOCATION WITH AN "X" IN SECTION BOX:

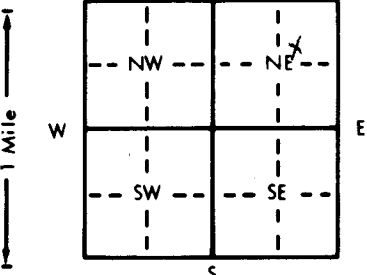

4 DEPTH OF COMPLETED WELL: **33** ft. ELEVATION:

Depth(s) Groundwater Encountered: 1. **21** ft. 2. ft. 3. ft.  
 WELL'S STATIC WATER LEVEL: **26** ft. below land surface measured on mo/day/yr **5/8/82**  
 Pump test data: Well water was **12** ft. after **1** hours pumping gpm  
 Est. Yield: **15** gpm Well water was ft. after hours pumping gpm  
 Bore Hole Diameter: **1.0** in. to ft., and in. to ft.  
 WELL WATER TO BE USED AS:  
 1 Domestic  2 Irrigation  3 Feedlot  4 Industrial  5 Public water supply  6 Oil field water supply  7 Lawn and garden only  8 Air conditioning  9 Dewatering  10 Observation well  11 Injection well  12 Other (Specify below)  
 Was a chemical/bacteriological sample submitted to Department? Yes No; If yes, mo/day/yr sample was submitted Water Well Disinfected?  Yes  No

5 TYPE OF BLANK CASING USED:  
 1 Steel  2 Brass  3 RMP (SR)  4 Galvanized steel  5 Wrought iron  6 Asbestos-Cement  7 Fiberglass  8 Concrete tile  9 Other (specify below)  10 PVC  11 Asbestos-cement  
 Blank casing diameter: **5** in. to **13** ft., Dia. in. to ft., Dia. in. to ft.  
 Casing height above land surface: **20** in., weight lbs./ft. Wall thickness or gauge No. **SDR 26**  
 TYPE OF SCREEN OR PERFORATION MATERIAL:  
 1 Steel  2 Brass  3 Stainless steel  4 Galvanized steel  5 Fiberglass  6 Concrete tile  7 RMP (SR)  8 PVC  9 ABS  10 Asbestos-cement  11 Other (specify)  12 None used (open hole)  
 SCREEN OR PERFORATION OPENINGS ARE:  
 1 Continuous slot  2 Louvered shutter  3 Mill slot  4 Key punched  5 Gauzed wrapped  6 Wire wrapped  7 Torch cut  8 Saw cut  9 Drilled holes  10 Other (specify)  11 None (open hole)  12 None (open hole)

SCREEN-PERFORATED INTERVALS: From **13** ft. to **33** ft., From ft. to ft., From ft. to ft.  
 GRAVEL PACK INTERVALS: From **10** ft. to **33** ft., From ft. to ft., From ft. to ft.

6 GROUT MATERIAL:  1 Neat cement  2 Cement grout  3 Bentonite  4 Other  
 Grout Intervals: From **0** ft. to **10** ft., From ft. to ft., From ft. to ft.

What is the nearest source of possible contamination:  
 1 Septic tank  2 Sewer lines  3 Watertight sewer lines  4 Lateral lines  5 Cess pool  6 Seepage pit  7 Pit privy  8 Sewage lagoon  9 Feedyard  10 Livestock pens  11 Fuel storage  12 Fertilizer storage  13 Insecticide storage  14 Abandoned water well  15 Oil well/Gas well  16 Other (specify below)

Direction from well? **North** How many feet? **400**

FROM	TO	LITHOLOGIC LOG	FROM	TO	LITHOLOGIC LOG
0	2	Top Soil			
2	18	sand (fine red)			
18	24	sand & brown clay mixed			
24	29	yellow limestone rock			
29	33	shale			

7 CONTRACTOR'S OR LANDOWNER'S CERTIFICATION: This water well was  (1) constructed, (2) reconstructed, or (3) plugged under my jurisdiction and was completed on (mo/day/year) **5/9/82** and this record is true to the best of my knowledge and belief. Kansas Water Well Contractor's License No. **274** This Water Well Record was completed on (mo/day/yr) **5/9/82** under the business name of **Luza Water Well** by (signature) **John Luza**

INSTRUCTIONS: Use typewriter or ball point pen, PLEASE PRESS FIRMLY and PRINT clearly. Please fill in blanks, underline or circle the correct answers. Send top three copies to Kansas Department of Health and Environment, Division of Environment, Environmental Geology Section, Topeka, KS 66620. Send one to WATER WELL OWNER and retain one for your records.

OFFICE USE ONLY T 13 R 24 E 28 SW 1/4 NE 1/4