USE TYPEWRITER OR BALL POINT PEN-PRESS FIRMLY, PRINT CLEARLY.

WATER WELL RECORD
KSA 82a-1201-1215

Kansas Department of Health and Environment-Division of Environment
(Water well Contractors)
Topeka, Kansas 66620

1. Location of well:	County	Fraction	Section number	Township number	Range number
	Trego	NE 1/4 NW 1/4 SW 1/4	27	T 13 S	R 25 E (W)

2. Distance and direction from nearest town or city: 1 east 9 south
Street address of well location if in city: 1 east of Collyer

3. Owner of well: Lavern Walt
R.R. or street:
City, state, zip code: Collyer, Ks. 67631

4. Locate with "X" in section below:

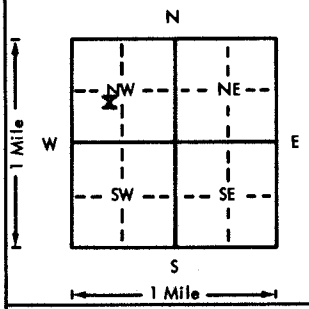

Sketch map:

5. Type and color of material	From	To
clay and silt	0	20
sand	20	28
clay	28	40
sand	40	55
shale	55	57

(Use a second sheet if needed)

6. Bore hole dia. 8 in. Completion date
Well depth 57 ft. 4/26/78

7. __ Cable tool X Rotary __ Driven __ Dug
__ Hollow rod __ Jetted __ Bored __ Reverse rotary

8. Use: __ Domestic __ Public supply __ Industry
__ Irrigation __ Air conditioning X Stock
__ Lawn __ Oil field water __ Other

9. Casing: Material
Threaded __ Welded __
RMP __ PVC X
Dia. 5 in. to 57 ft. depth
Dia. __ in. to __ ft. depth
Height: above or below
Surface 12 in.
Weight __ lbs./ft.
Wall Thickness: inches or gage No. 250

10. Screen: Manufacturer's name Peerless Plastics
Type pvc Dia. 5 in.
Slot/gauze 1/16 Length 10 ft.
Set between 47 ft. and 57 ft.
ft. and ft.
Gravel pack? X Size range of material 1 down

11. Static water level: mo./day/yr.
20 ft. below land surface Date 4/26/78

12. Pumping level below land surfaces:
ft. after hrs. pumping g.p.m.
ft. after hrs. pumping g.p.m.
Estimated maximum yield g.p.m.

13. Water sample submitted: mo./day/yr.
__ Yes X No Date

14. Well head completion:
__ Pitless adapter __ Inches above grade

15. Well grouted? X
With: clay __ Neat cement __ Bentonite __ Concrete
Depth: From 0 ft. to 5 ft.

16. Nearest source of possible contamination:
ft. Direction Type
Well disinfected upon completion? __ Yes X No

17. Pump: X Not installed
Manufacturer's name
Model number HP Volts
Length of drop pipe ft. capacity g.p.m.
Type:
__ Submersible __ Turbine
__ Jet __ Reciprocating
__ Centrifugal __ Other

T R W Sec 1/4 1/4 1/4

18. Elevation:
Topography:
__ Hill
__ Slope
__ Upland
X Valley

19. Remarks:

20. Water well contractor's certification:
This well was drilled under my jurisdiction and this report is true to the best of my knowledge and belief.
Aqua Well Drilling 281
Business name License No.
Address Gove, Ks. 67736
Signed J. M. Little Date 5-7-78
Authorized representative

Forward the white, blue and pink copies to the Department of Health and Environment

Form WWC-5

MI-1023