USE TYPEWRITER OR BALL POINT PEN-PRESS FIRMLY, PRINT CLEARLY.

WATER WELL RECORD
KSA 82a-1201-1215

Kansas Department of Health and Environment-Division of Environment
(Water well Contractors)
Topeka, Kansas 66620

1. Location of well:	County: Trego	Fraction: NW 1/4 NE 1/4 NW 1/4	Section number: 6	Township number: T 13 S	Range number: R 25 E/W

2. Distance and direction from nearest town or city:
Street address of well location if in city: 75 1/2 / collyer

3. Owner of well: Ed Ziegler
R.R. or street:
City, state, zip code: Collyer, Ks

4. Locate with "X" in section below:

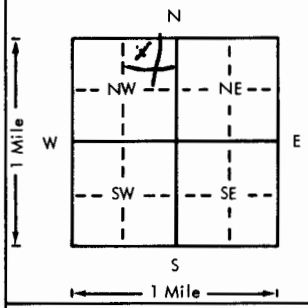

Sketch map:

6. Bore hole dia. 9 in. Completion date 5-81
Well depth 67 ft.

7. __ Cable tool X Rotary __ Driven __ Dug
__ Hollow rod __ Jetted __ Bored __ Reverse rotary

8. Use: X Domestic __ Public supply __ Industry
__ Irrigation __ Air conditioning __ Stock
__ Lawn __ Oil field water __ Other

9. Casing: Material _____ Height: Above or below
Threaded ____ Welded ____ Surface 12 in.
RMP ____ PVC X Weight 200 lbs./ft.
Dia. 0 in. to 67 ft. depth Wall Thickness: inches or
Dia. ____ in. to ____ ft. depth gage No. 214

5. Type and color of material	From	To
Top soil	0	7
Sandy Clay	7	20
M Gravel	20	25
Sandy Clay	25	40
M Gravel	40	47
Sand Stone	47	49
M Gravel	49	56
Sandy Clay	56	65
Ochre	65	67

(Use a second sheet if needed)

10. Screen: Manufacturer's name Jess Lowell
Type PVC Dia. 5"
Slot/gauze 1/16-1/8 Length
Set between 57 ft. and 67 ft.
____ ft. and ____ ft.
Gravel pack? X Size range of material 1/4-3/16

11. Static water level: mo./day/yr.
40 ft. below land surface Date 5-81

12. Pumping level below land surfaces:
____ ft. after ____ hrs. pumping ____ g.p.m.
____ ft. after ____ hrs. pumping ____ g.p.m.
Estimated maximum yield 10 g.p.m.

13. Water sample submitted: mo./day/yr.
__ Yes X No Date

14. Well head completion:
X Pitless adapter 12 Inches above grade

15. Well grouted? yes
With: X Neat cement __ Bentonite __ Concrete
Depth: From 0 ft. to 10 ft.

16. Nearest source of possible contamination:
ft. 100 Direction N Type Sewer
Well disinfected upon completion? X Yes __ No

17. Pump: __ Not installed
Manufacturer's name Goulds
Model number 10EJ HP 1/2 Volts 230
Length of drop pipe 60 ft. capacity 10 g.p.m.
Type:
X Submersible __ Turbine
__ Jet __ Reciprocating
__ Centrifugal __ Other

18. Elevation:
Topography:
__ Hill
__ Slope
X Upland
__ Valley

19. Remarks:

20. Water well contractor's certification:
This well was drilled under my jurisdiction and this report is true to the best of my knowledge and belief.
B & B Drilling 376
Business name License No.
Address Grinnell, Ks
Signed Joseph Beilman Date 5-81
Authorized representative

T 13 R 25 E/W Sec 6 1/4 1/4 1/4 NW NE

Forward the white, blue and pink copies to the Department of Health and Environment

Form WWC-5

MI-1023