


1 LOCATION OF WATER WELL: Fraction Section Number Township Number Range Number
 County: Gove $\frac{1}{4}$ SE $\frac{1}{4}$ NE $\frac{1}{4}$ 26 13 26 **EW**

Distance and direction from nearest town or city street address of well if located within city?
11 South, 4 East of Quinter

2 WATER WELL OWNER: Marcia Pfeifer
 RR #, St. Address, Box #: 1716 Harvest Rd Board of Agriculture, Division of Water Resources
 City, State, ZIP Code: Hays, KS 67601 Application Number: _____

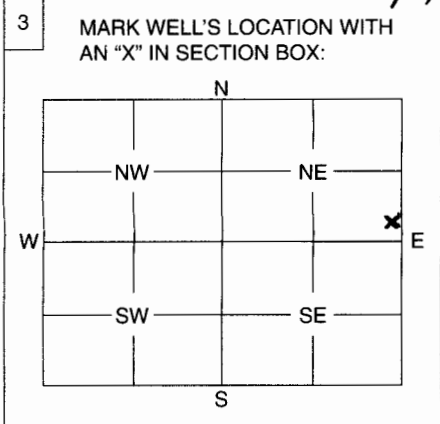

4 DEPTH OF WELL 63 ft.
 WELL'S STATIC WATER LEVEL 10.5 ft. Depth to Water 52.5'
 WELL WAS USED AS:
 1 Domestic 2 Irrigation 3 Feedlot 4 Industrial 5 Public Water Supply 6 Oil Field Water Supply 7 Domestic (Lawn & Garden) 8 Air Conditioning 9 Dewatering 10 Monitoring Well 11 Injection Well 12 Other Livestock
 Was a chemical / bacteriological sample submitted to Department? Yes No
 If yes, mo/day/yr sample was submitted
 Water Well Disinfected: Yes No

5 TYPE OF BLANK CASING USED:
 1 Steel 2 PVC 3 RMP (SR) 4 ABS 5 Wrought 6 Asbestos-Cement 7 Fiberglass 8 Concrete Tile 9 Other (Specify below)
 Blank casing diameter 5 in. Was casing pulled? Yes No If yes, how much 6 ft.
 Casing height above below land surface 18 in.

6 GROUT PLUG MATERIAL: 1 Neat cement 2 Cement grout 3 Bentonite 4 Other
 Grout Plug Intervals: From 3 ft. to 7 ft., From ft. to ft., From to ft.
 What is the nearest source of possible contamination:
 1 Septic tank 2 Sewer lines 3 Watertight sewer lines 4 Lateral lines 5 Cess pool 6 Seepage pit 7 Pit privy 8 Sewage lagoon 9 Feedyard 10 Livestock pens 11 Fuel storage 12 Fertilizer storage 13 Insecticide storage 14 Abandoned water well 15 Oil well/Gas well 16 Other (specify below) Farm House
 Direction from well? West How many feet? 3,000

FROM	TO	PLUGGING MATERIALS
0	3'	Top Soil
3'	7'	Bentonite Plug
7'	52.5'	Clay
52.5'	63'	Sand

7 CONTRACTOR'S OF LANDOWNER'S CERTIFICATION: This water well was plugged under my jurisdiction and was completed on (mo/day/year) 5/18/2010 and this record is true to the best of my knowledge and belief. Kansas Water Well Contractor's License No. This Water Well Record was completed on (mo/day/year) 5/21/2010 under the business name of
 by (signature) Marcia Pfeifer

INSTRUCTIONS: Use typewriter or ball point pen. Please press firmly and print clearly. Please fill in blanks, underline or circle the correct answers. Send top three copies to Kansas Department of Health and Environment, Bureau of Water, Geology Section, 1000 SW Jackson St., Ste. 420, Topeka, Kansas 66612-1367. Telephone: 785/296-5522. Send one to Water Well Owner and retain one for your records.