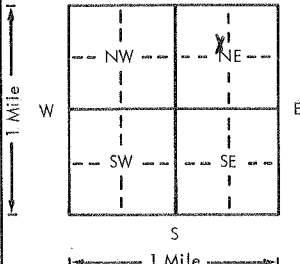


USE TYPEWRITER OR BALL POINT PEN-PRESS FIRMLY, PRINT CLEARLY.

WATER WELL RECORD
KSA 82a-1201-1215

Kansas Department of Health and Environment-Division of Environment
(Water well Contractors)
Topeka, Kansas 66620

1. Location of well:	County Gove	Fraction SE 1/4 NW 1/4 NE 1/4	Section number 29	Township number T 13	Range number S R 26	(EW)
2. Distance and direction from nearest town or city: Street address of well location if in city:		10 SOUTH 3/4 EAST of Quinter		3. Owner of well: R.R. or street: City, state, zip code:		
				Edwin Courtney Quinter Ks. 67752		
4. Locate with "X" in section below: N  W E S			Sketch map:		6. Bore hole dia. 1 1/2 in. Completion date _____ Well depth 65 ft. 7-2-75	
5. Type and color of material			From	To	7. Cable tool _____ Rotary _____ Driven _____ Dug _____ Hollow rod _____ Jetted _____ Bored <input checked="" type="checkbox"/> Reverse rotary	
					8. Use: _____ Domestic _____ Public supply _____ Industry <input checked="" type="checkbox"/> Irrigation _____ Air conditioning _____ Stock _____ Lawn _____ Oil field water _____ Other	
					9. Casing: Material C.A. Height: Above or below Threaded _____ Welded _____ Surface 12 in. RMP _____ PVC _____ Weight _____ lbs./ft. Dia. _____ in. to _____ ft. depth Wall Thickness: inches or Dia. _____ in. to _____ ft. depth gage No. _____	
					10. Screen: Manufacturer's name _____ JOHNSON Type Cement asbestos Dia. 12" Slot/gauze 3/16 Length _____ Set between 26 ft. and 65 ft. _____ ft. and _____ ft. Gravel pack? <input checked="" type="checkbox"/> yes Size range of material 1/2 down	
					11. Static water level: _____ mo./day/yr. 22 ft. below land surface Date 7-2-75	
					12. Pumping level below land surfaces: _____ ft. after _____ hrs. pumping _____ g.p.m. _____ ft. after _____ hrs. pumping _____ g.p.m. Estimated maximum yield 300 g.p.m.	
					13. Water sample submitted: _____ mo./day/yr. Yes <input checked="" type="checkbox"/> No _____ Date _____	
					14. Well head completion: _____ Pitless adapter _____ Inches above grade	
					15. Well grouted? <input checked="" type="checkbox"/> Cement slab With: _____ Neat cement _____ Bentonite _____ Concrete Depth: From _____ ft. to _____ ft.	
					16. Nearest source of possible contamination: ft. _____ Direction _____ Type _____ Well disinfected upon completion? _____ Yes _____ No	
					17. Pump: <input checked="" type="checkbox"/> Not installed Manufacturer's name _____ Model number _____ HP _____ Volts _____ Length of drop pipe _____ ft. capacity _____ g.p.m. Type: _____ Submersible _____ Turbine _____ Jet _____ Reciprocating _____ Centrifugal _____ Other	
			(Use a second sheet if needed)			
18. Elevation:		19. Remarks:		20. Water well contractor's certification: This well was drilled under my jurisdiction and this report is true to the best of my knowledge and belief. Aqua Well Drilling 281 Business name _____ License No. _____ Address Gove Kansas Signed J.M. Tuttle Date 6-20-77 Authorized representative		
Topography: _____ Hill _____ Slope _____ Upland <input checked="" type="checkbox"/> Valley						

Forward the white, blue and pink copies to the Department of Health and Environment

Form WWC-5

LOG OF EXPLORATORY HOLE

JOB NO. _____ JOB NAME Ed Courtney DATE 12-5-74
 HOLE NO. _____ HOLE ELEVATION _____ DRILLER Tuttle - Wildeman
 HOLE LOCATION _____

DEPTH		SOIL SYMBOL	SOIL DESCRIPTION	
FROM	TO			
	<u>2</u>			
1-0	30			(3)
2-0	50			
3-0	50			
4-0	54			(2)
<i>Good</i> 5-0	65		<i>No. 5</i> 15-25 sand or gravel 25-40 blue mud 40-65 good gravel 65 shells	(1) (4)
	400			(5) <i>Good</i>
<i>Bad</i> 8-0	63			(7)
9-0	62			
10-0	56			(6)
11-0	35			(11)
12-0	55			(14)
13-0	25			
14-0	30			(12)
	26			(13)
	20			
	26			
	26			
	26			
	30			

MOISTURE			HARDNESS			% SAND GRAVEL	% FINES (-200)	GRADING				COLOR	BEDROCK			CONDITION					OTHER
DRY	MOIST	WET	SOFT	FIRM	HARD			FINE	MEDIUM	COARSE	GRAVEL		CLAYSTONE	SILTSTONE	SANDSTONE	CEMENTED	MASSIVE	STRAT.	FRACTURED	POROUS	

DEPTH TO BEDROCK _____ DEPTH TO WATER TABLE _____