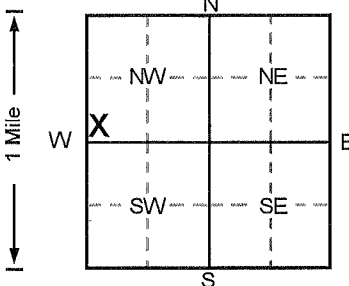


1 LOCATION OF WATER WELL: County: Saline	Fraction SW 1/4 SW 1/4 NW 1/4	Section Number 36	Township Number T 13 S	Range Number R 3 E/W
--	---	-----------------------------	----------------------------------	---------------------------------------

Distance and direction from nearest town or city street address of well if located within city?
120 W. Diamond Drive - Salina

2 WATER WELL OWNER: Triplett, Inc. RR#, St. Address, Box # : P.O. Box 647 City, State, ZIP Code : Salina, Kansas 67402	Board of Agriculture, Division of Water Resources Application Number:
---	--

3 LOCATE WELL'S LOCATION WITH AN "X" IN SECTION BOX: 	4 DEPTH OF COMPLETED WELL 28 ft. ELEVATION: Depth(s) Groundwater Encountered 1. 22 ft. 2. ft. 3. ft. WELL'S STATIC WATER LEVEL ... 21.95 ... ft. below land surface measured on mo/day/yr ... 4/23/96 Pump test data: Well water was ... NA ... ft. after hours pumping gpm Est. Yield .. NA .. gpm: Well water was ft. after hours pumping gpm Bore Hole Diameter 8 ... in. to 28 ft., and in. to ft. WELL WATER TO BE USED AS: 5 Public water supply 8 Air conditioning 11 Injection well 1 Domestic 3 Feedlot 6 Oil field water supply 9 Dewatering 12 Other (Specify below) 2 Irrigation 4 Industrial 7 Lawn and garden only 10 Monitoring well Was a chemical/bacteriological sample submitted to Department? Yes.....No ✓; If yes, mo/day/yr sample was submitted Water Well Disinfected? Yes No ✓
--	--

5 TYPE OF BLANK CASING USED: 1 Steel 2 PVC 3 RMP (SR) 4 ABS 5 Wrought iron 6 Asbestos-Cement 7 Fiberglass 8 Concrete tile 9 Other (specify below) CASING JOINTS: Glued Clamped Welded Threaded. ✓	Blank casing diameter 2 in. to 13 ft., Dia in. to ft., Dia in. to ft. Casing height above land surface 0 in., weight lbs./ft. Wall thickness or gauge No. Sch. 40 TYPE OF SCREEN OR PERFORATION MATERIAL 1 Steel 2 Brass 3 Stainless steel 4 Galvanized steel 5 Fiberglass 6 Concrete tile 7 PVC 8 RMP (SR) 9 ABS 10 Asbestos-cement 11 Other (specify) 12 None used (open hole)
SCREEN OR PERFORATION OPENINGS ARE: 1 Continuous slot 2 Louvered shutter 3 Mill slot 4 Key punched 5 Gauzed wrapped 6 Wire wrapped 7 Torch cut 8 Saw cut 9 Drilled holes 10 Other (specify) 11 None (open hole)	SCREEN-PERFORATED INTERVALS: From 13 ft. to 28 ft., From ft. to ft., From ft. to ft. GRAVEL PACK INTERVALS: From 11 ft. to 28 ft., From ft. to ft., From ft. to ft.

6 GROUT MATERIAL: 1 Neat cement 2 Cement grout 3 Bentonite 4 Other Grout Intervals: From 0 ft. to 9 ft., From 9 ft. to 11 ft., From ft. to ft.	What is the nearest source of possible contamination: 1 Septic tank 2 Sewer lines 3 Watertight sewer lines 4 Lateral lines 5 Cess pool 6 Seepage pit 7 Pit privy 8 Sewage lagoon 9 Feedyard 10 Livestock pens 11 Fuel storage 12 Fertilizer storage 13 Insecticide storage 14 Abandoned water well 15 Oil well/Gas well 16 Other (specify below) UST Basin.
Direction from well? SE	How many feet? 320

FROM	TO	LITHOLOGIC LOG	FROM	TO	PLUGGING INTERVALS
0	2	Clay, Dark Brown to Rust Brown			
2	8	Clay, Dark Brown			
8	10	Clay, Medium Brown			
10	17	Clay, Light Brown			
17	28	Clay, Light Brown			
					MW15, Tag # 00160360, Flushmount
					Project Name: Al's Diner-UST
					GeoCore # 201, KDHE # U5 085 1015

7 CONTRACTOR'S OR LANDOWNER'S CERTIFICATION: This water well was (1) constructed, (2) reconstructed, or (3) plugged under my jurisdiction and was completed on (mo/day/year) 3/27/96 and this record is true to the best of my knowledge and belief. Kansas Water Well Contractor's License No. 527 This Water Well Record was completed on (mo/day/yr) 4/25/96 under the business name of GeoCore Services, Inc. by (signature) <i>One Bell</i>
--