


1 LOCATION OF WATER WELL: Fraction SW 1/4 SW 1/4 NW 1/4 Section Number 36 Township Number T 13 S Range Number R 3

Distance and direction from nearest town or city street address of well if located within city? 120 W. Diamond Drive - Salina

2 WATER WELL OWNER: Triplett, Inc. RR#, St. Address, Box#: P.O. Box 647 City, State, ZIP Code: Salina, Kansas 67402-0647 Board of Agriculture, Division of Water Resources Application Number:

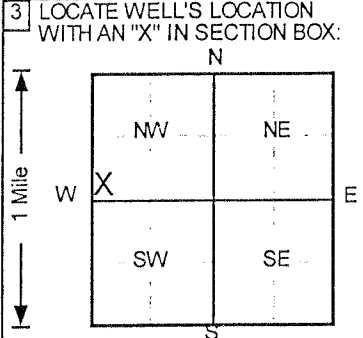

4 DEPTH OF COMPLETED WELL: 28 ft. ELEVATION: 1218.27. Depth(s) Groundwater Encountered: 1. 999 ft. 2. ... ft. 3. ... ft. WELL'S STATIC WATER LEVEL: 18.2 ft. below land surface measured on mo/day/yr 1/21/97.

5 TYPE OF BLANK CASING USED: 2 PVC. Casing diameter: 2 in. to 13 ft. Dia. Casing height above land surface: -5.88 in., weight ... lbs./ft. Wall thickness or gauge No. Sch. 40. TYPE OF SCREEN OR PERFORATION MATERIAL: 7 PVC. SCREEN OR PERFORATION OPENINGS ARE: 3 Mill slot. SCREEN-PERFORATED INTERVALS: From 13 ft. to 28 ft. GRAVEL PACK INTERVALS: From 11 ft. to 28 ft.

6 GROUT MATERIAL: 2 Cement grout, 3 Bentonite. Grout Intervals: From 0 ft. to 9 ft., From 9 ft. to 11 ft. What is the nearest source of possible contamination: 16 Other (specify below) UST Basin. Direction from well? South. How many feet? 560.

Table with columns: FROM, TO, LITHOLOGIC LOG, FROM, TO, PLUGGING INTERVALS. Rows show soil layers: 0-1 Topsoil, 1-16 Clay, Brown, 16-28 Clay, Brown. Includes well details: MW22, Tag # 00189750, Flushmount; Project Name: Al's Diner - Monitoring; GeoCore # 338, KDHE # U5 085 1015.

7 CONTRACTOR'S OR LANDOWNER'S CERTIFICATION: This water well was (1) constructed, (2) reconstructed, or (3) plugged under my jurisdiction and was completed on (mo/day/year) 11/22/96 and this record is true to the best of my knowledge and belief. Kansas Water Well Contractor's License No. 527. This Water Well Record was completed on (mo/day/yr) 4/14/97 under the business name of GeoCore Services, Inc. by (signature) Bob Roll.

INSTRUCTIONS: Use typewriter or ball point pen. PLEASE PRESS FIRMLY and PRINT clearly. Please fill in blanks, underline or circle the correct answers. Send top three copies to Kansas Department of Health and Environment, Bureau of Water, Topeka, Kansas 66620-0001. Telephone: 913-296-5545. Send one to WATER WELL OWNER and retain one for your records.

OFFICE USE ONLY

T

R

EW

SEC.

1/4

1/4

1/4