


1 LOCATION OF WATER WELL:	Fraction	Section Number	Township Number	Range Number
County: SALINE	SW 1/4 SW 1/4 NE 1/4	9	T 13 S	R 3W E/W

Distance and direction from nearest town or city street address of well if located within city?
 2566 W. HUMBARGER RD. SALINE COUNTY PERMIT # 99-213

2 WATER WELL OWNER: WILLIAM CAPE
 RR#, St. Address, Box # : 3472 W. SHIPTON RD.
 City, State, ZIP Code : SALINA, KS. 67401
 Board of Agriculture, Division of Water Resources
 Application Number:

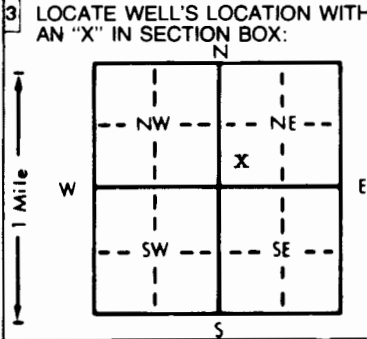

4 DEPTH OF COMPLETED WELL: 50.3 ft. ELEVATION:
 Depth(s) Groundwater Encountered 1. 19.8 ft. 2. ft. 3. ft.
 WELL'S STATIC WATER LEVEL: 19.8 ft. below land surface measured on mo/day/yr 10-15-99
 Pump test data: Well water was ft. after hours pumping gpm
 Est. Yield .100 gpm: Well water was ft. after hours pumping gpm
 Bore Hole Diameter 12 in. to 51 in. to ft. and in. to ft.
 WELL WATER TO BE USED AS:
 1 Domestic 2 Irrigation 3 Feedlot 4 Industrial 5 Public water supply 6 Oil field water supply 7 Lawn and garden only 8 Air conditioning 9 Dewatering 10 Monitoring well 11 Injection well 12 Other (Specify below)
 Was a chemical/bacteriological sample submitted to Department? Yes No X If yes, mo/day/yr sample was submitted
 Water Well Disinfected? Yes X No

5 TYPE OF BLANK CASING USED:
 1 Steel 2 PVC 3 RMP (SR) 4 ABS 5 Wrought iron 6 Asbestos-Cement 7 Fiberglass 8 Concrete tile 9 Other (specify below)
 CASING JOINTS: Glued X Clamped Welded Threaded
 Blank casing diameter 6 in. to 40 ft. Dia. in. to ft. Dia. in. to ft.
 Casing height above land surface 14 in., weight 200 lbs./ft. Wall thickness or gauge No. SDR26
 TYPE OF SCREEN OR PERFORATION MATERIAL:
 1 Steel 2 Brass 3 Stainless steel 4 Galvanized steel 5 Fiberglass 6 Concrete tile 7 PVC 8 RMP (SR) 9 ABS 10 Asbestos-cement 11 Other (specify) 12 None used (open hole)
 SCREEN OR PERFORATION OPENINGS ARE:
 1 Continuous slot 2 Louvered shutter 3 Mill slot .025 4 Key punched 5 Gauzed wrapped 6 Wire wrapped 7 Torch cut 8 Saw cut 9 Drilled holes 10 Other (specify) 11 None (open hole)
 SCREEN-PERFORATED INTERVALS: From 40 ft. to 50 ft. From ft. to ft. From ft. to ft. From ft. to ft.
 GRAVEL PACK INTERVALS: From 35 ft. to 50.3 ft. From ft. to ft. From ft. to ft. From ft. to ft.

6 GROUT MATERIAL: 1 Neat cement 2 Cement grout 3 Bentonite 4 Other
 Grout Intervals: From 5 ft. to 35 ft. From ft. to ft. From ft. to ft. From ft. to ft.
 What is the nearest source of possible contamination:
 1 Septic tank 2 Sewer lines 3 Watertight sewer lines 4 Lateral lines 5 Cess pool 6 Seepage pit 7 Pit privy 8 Sewage lagoon 9 Feedyard 10 Livestock pens 11 Fuel storage 12 Fertilizer storage 13 Insecticide storage 14 Abandoned water well 15 Oil well/Gas well 16 Other (specify below)
 OPEN FIELD NONE APPARENT
 Direction from well? How many feet?

FROM	TO	LITHOLOGIC LOG	FROM	TO	PLUGGING INTERVALS
0	2	TOP SOIL BLACK			
2	32	CLAY BROWN SILTY			
32	42	CLAY GRAY SOFT			
42	51	SAND FINE TO MED. TAN			

7 CONTRACTOR'S OR LANDOWNER'S CERTIFICATION: This water well was (1) constructed, (2) reconstructed, or (3) plugged under my jurisdiction and was completed on (mo/day/year) 10-27-99 and this record is true to the best of my knowledge and belief. Kansas Water Well Contractor's License No. 388 This Water Well Record was completed on (mo/day/yr) 10-27-99 under the business name of PESTINGER PUMP SERVICE by (signature) [Signature]

INSTRUCTIONS: Use typewriter or ball point pen. PLEASE PRESS FIRMLY and PRINT clearly. Please fill in blanks, underline or circle the correct answers. Send top three copies to Kansas Department of Health and Environment, Bureau of Water, Topeka, Kansas 66620-0001. Telephone: 913-296-5545. Send one to WATER WELL OWNER and retain one for your records.

OFFICE USE ONLY T R E/W SEC. 1/4 1/4 1/4